RED ROAD DIV. NO.	STATE	PROJECT NO.	FISCAL YEAR	SHEET NO.
3	FLA.	09060-2901		1

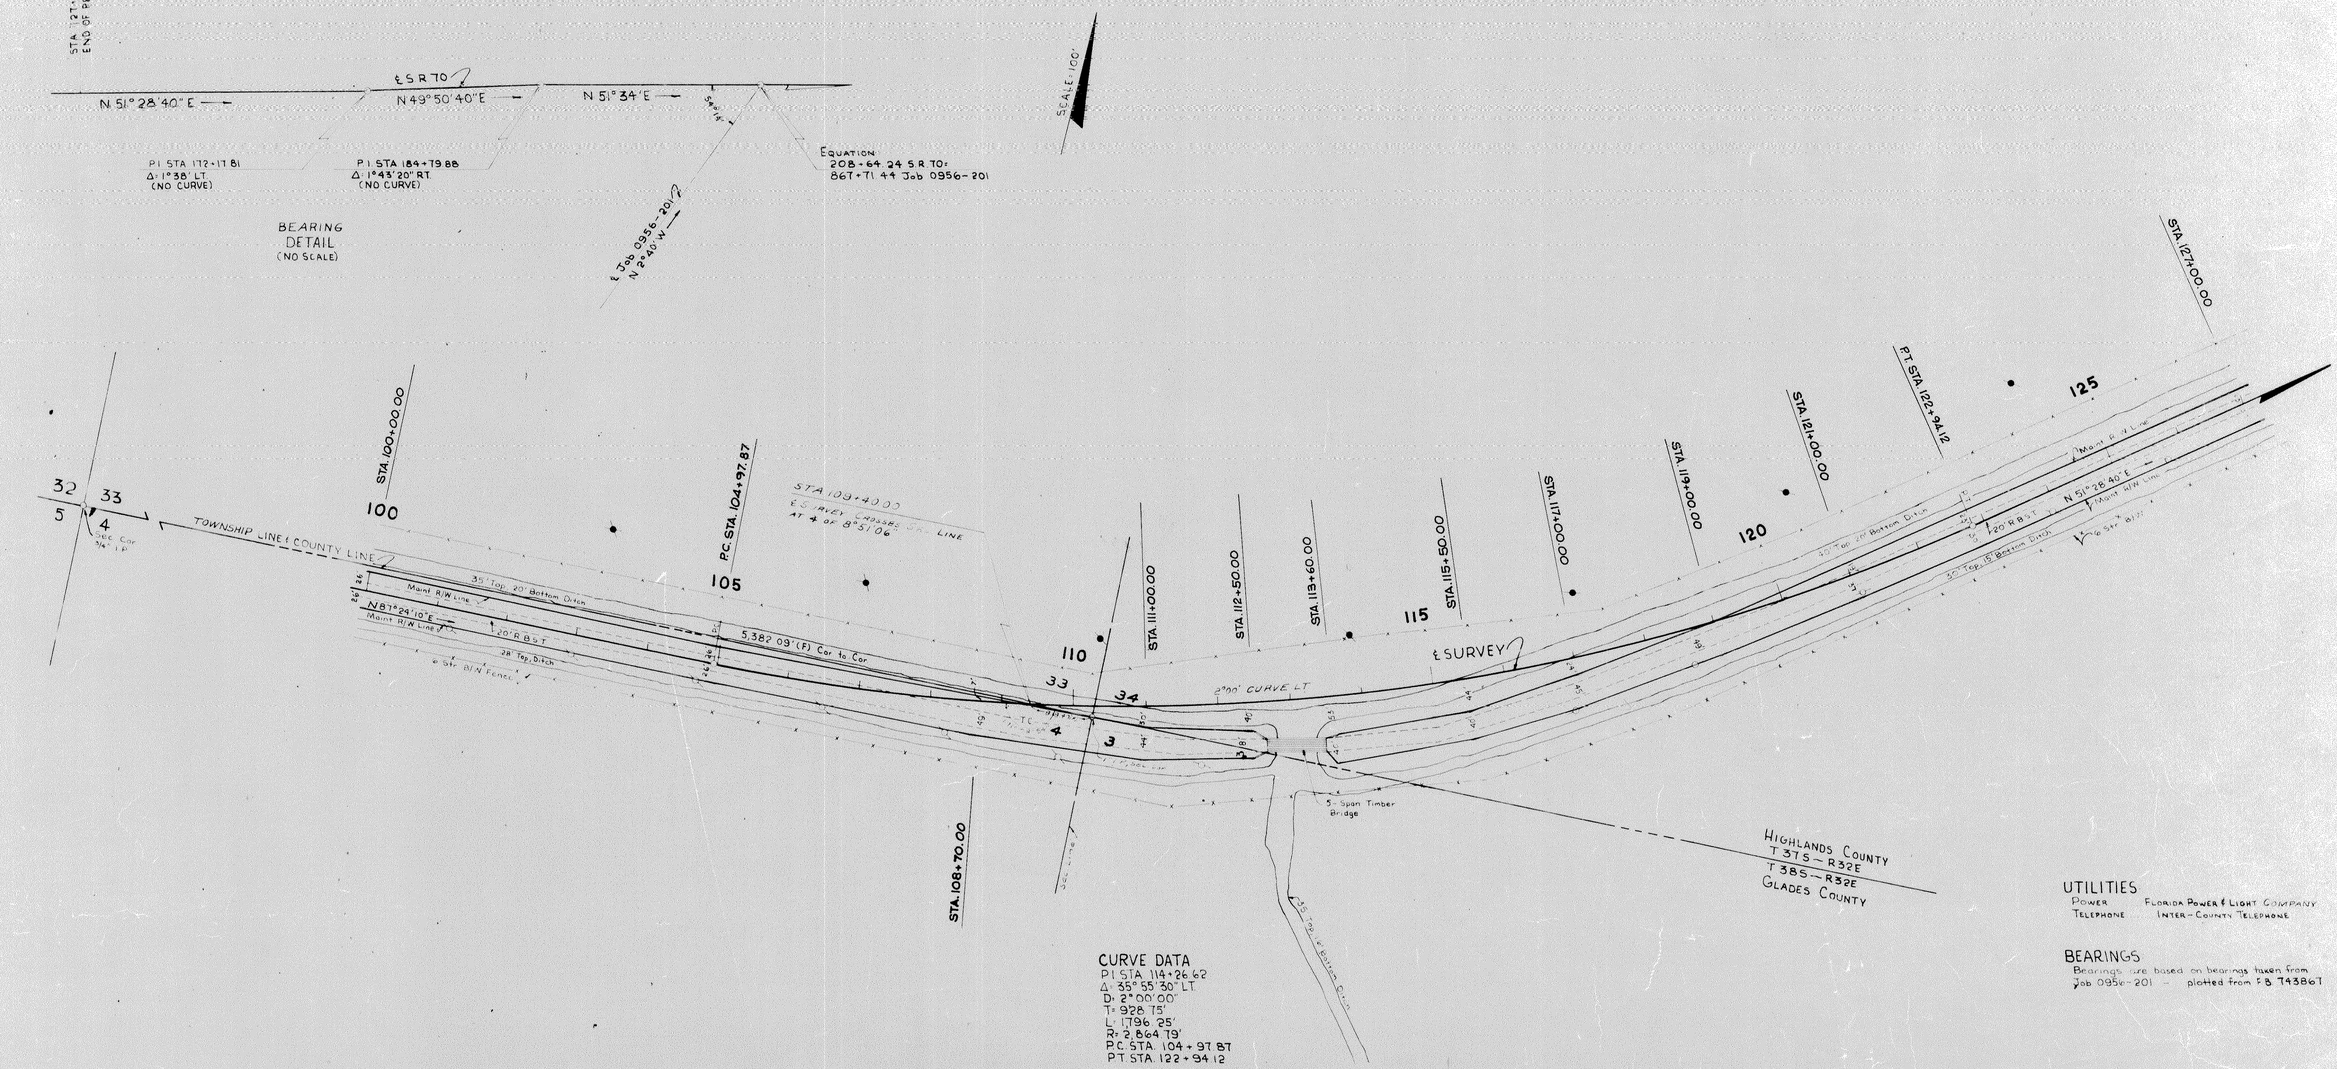

CURVE DATA
P.I. STA. 114+26.62
Δ: 35°55'30" LT.
D: 2°00'00"
T: 928.75'
L: 1,796.25'
R: 2,864.79'
P.C. STA. 104+97.87
P.T. STA. 122+94.12

UTILITIES
POWER — FLORIDA POWER & LIGHT COMPANY
TELEPHONE — INTER-COUNTY TELEPHONE

BEARINGS
Bearings are based on bearings taken from Job 0956-201 — plotted from F.B. 743867

THIS IS TO CERTIFY that the within and attached sheets numbered one (1) to ____, inclusive, constitute a true copy of the official Right of Way Map showing location and survey by the State Road Department of Florida for a portion of State Road 70 designated as Section 09060 in Highlands Co., Florida.

THE PROPERTY outlined in RED ink on the said sheets has been vested in the State Road Department of Florida, pursuant to the provisions of Section 341.59 Florida Statutes of 1951 and Section 337.31 Florida Statutes of 1955, and/or under formal conveyance and other instruments.

IN WITNESS WHEREOF, We have hereunto set our hands and affixed the seal of the State Road Department of Florida, at Tallahassee, Florida, this 14th day of Feb. A.D. 1966.

Ralph Davis
Executive Director, State Road Department of Florida

F. L. Strickland
Secretary, State Road Department of Florida

ACCEPTED for files and recorded in the Public Records of _____ Co., Florida, this _____ day of _____ A.D. 19__, in Road Plat Book _____ Page _____

Clerk of Circuit Court of _____ Co., Florida

STATE OF FLORIDA
STATE ROAD DEPARTMENT

MAINTAINED
RIGHT OF WAY MAP

STATE ROAD NO. 70 — HIGHLANDS COUNTY

	BY	DATE	APPROVED BY	DATE
DRAWN	L.R.J.	1-25-66	H. M. Johnson	DISTRICT ENGINEER
TRACED				
CHECKED	D.C.	1-25-66	[signature]	ENGINEER OF RIGHTS OF WAY
COMPARED				
INDEXED				STATE HIGHWAY ENGINEER

SECTION 09060-2901 — SHEET 1 OF