STATE JOB NO. 12010-2906

FED. ROAD DIV. NO.	STATE	PROJECT NO.	FISCAL YEAR	SHEET NO.
3	FLA.	HES-301-2(12)		

INDEX OF SHEETS

SHEET NO.

STATE OF FLORIDA
DEPARTMENT OF TRANSPORTATION

PLANS OF THE

STATE HIGHWAY RIGHT OF WAY MAP

F.A. PROJECT NO. HES-301-2(12)

LEE COUNTY

STATE ROAD NO. 45

LENGTH: 0.137 MILES

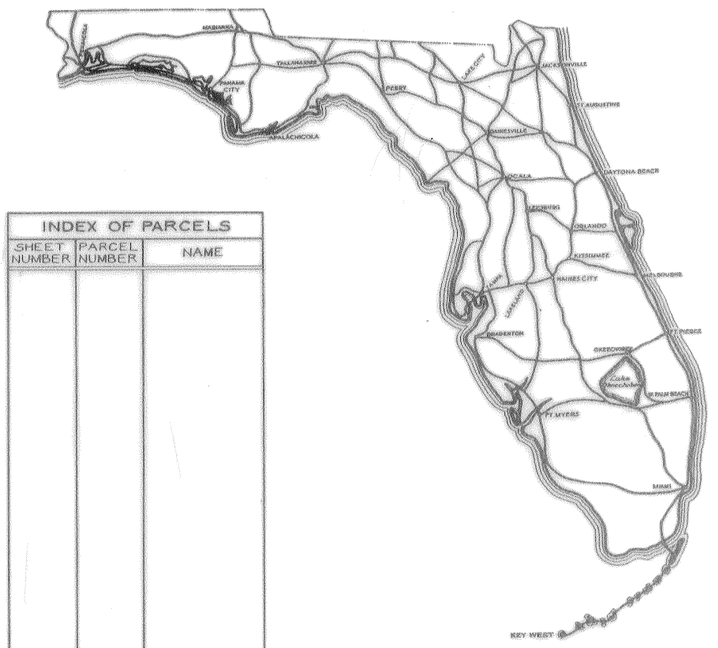

INDEX OF PARCELS		
SHEET NUMBER	PARCEL NUMBER	NAME

SEE TABLE OF OWNERSHIPS ON DETAIL SHEETS FOR INDEX INFORMATION

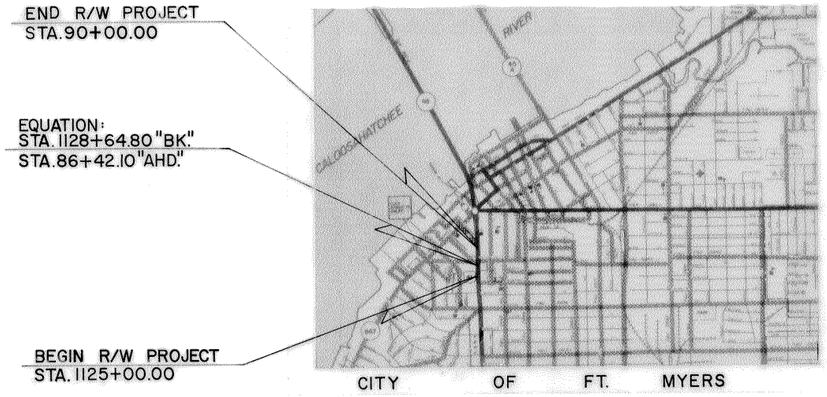

TWP. 44 S. – RGE. 24 E.
SECTIONS 23 & 24

CONVENTIONAL SIGNS

COUNTY LINE		TRAVELED WAY	
TOWNSHIP LINE		BUILDINGS	
SECTION LINE		BRIDGES OVER 20 FT. SPAN	
UNFENCED PROPERTY		POWER POLE	
CITY LINE		TELEPHONE POLE	
FENCE LINE		MARSH	
RIGHT OF WAY LINE		BURIED UTILITY	TYPE
BASE OR SURVEY LINE		LIGHT STANDARD	
RAILROADS		R. R. MILE POST	
LIMITED ACCESS LINE		PROPERTY LINE	
LIMIT OF SLOPE			

APPROVED BY FEDERAL HIGHWAY ADMINISTRATION-DATE. _____

ATTENTION IS DIRECTED TO THE FACT THAT THIS MAP MAY HAVE BEEN REDUCED IN SIZE BY REPRODUCTION. THIS MUST BE CONSIDERED WHEN OBTAINING SCALED DATA

SUBMITTED BY

William A. Rawlings
ENGINEER OF RIGHTS OF WAY

APPROVED _____ DATE _____

DIVISION ADMINISTRATOR
FEDERAL HIGHWAY ADMINISTRATION

BY: DIVISION RIGHT OF WAY OFFICER

LEE CO. 12010-2906

AF 9782

F.A. PROJECT NO.	SHEET NO.
HES-301-2(12)	

COHEN'S
PLAT OF A PART OF THE TOWN OF MYERS
Filed March 9, 1889; P.B. 2, Pg. 6

CLEVELAND AVE. REALTY CO., INC. SUBDIVISION
Filed March 26, 1930; P.B. 8, Pg. 46

A.W. BRADLEY'S SUBDIVISION
Filed July 8, 1903; P.B. 1, Pg. 24

WEST END SUBDIVISION
Filed March 27, 1912; P.B. 3, Pg. 19

CITY OF FORT MYERS

PLAT OF
BLOCK "A" FORT MYERS FLORIDA
Filed June 4, 1898; P.B. 1, Pg. 31

Sec. Cor. 13 24 23 14

T44S — R24E

SCALE: 1" = 50'

END R/W JOB
STA. 90+00.00

BEGIN R/W JOB
STA. 1125+00.00

(VICTORIA AVENUE)
BEGIN R/W ACQUISITION
BEGIN F.A. PARTICIPATION (R/W)
STA. 25+31.00

(VICTORIA AVENUE)
END R/W ACQUISITION
END F.A. PARTICIPATION (R/W)
STA. 93+90.92

TOURNAMENT STREET

HEITMAN STREET

CLIFFORD STREET

CLEVELAND AVE.
REALTY CO., INC. SUB'D.
Filed March 26, 1930; P.B. 8, Pg. 46

ALTAMONT PARK
Filed April 3, 1924; P.B. 5, Pg. 12

℄ SURVEY VICTORIA AVE.

℄ SURVEY 12010-2123 (S.R. 45 & CLEVELAND AVE.)

EQUATION:
STA. 30+00.00 ℄ SURVEY VICTORIA AVE.
= STA. 86+79.11 ℄ 12010-2123 (S.R. 45)

P.I. STA. 29+97.75
Δ = 0°12'26" LT. (NO CURVE)
N. & T., NE COR. SE 1/4, NE 1/4, SEC. 23

EQUATION:
STA. 86+42.10 AHD ℄ 12010-2123

INTERSECTION
S.R. 45 AT VICTORIA AVENUE

(F) Indicates Field Dimension

UTILITY OWNERS
TELEPHONE . . . . . United Telephone System of Florida
GAS . . . . . South Florida Gas Company
POWER . . . . . Florida Power and Light Company
WATER . . . . . City of Fort Myers
SAN. SEWERS . . . . . City of Fort Myers
STORM SEWERS . . . . . City of Fort Myers

BEARINGS ARE TAKEN FROM 12010-2123

REVISION	BY	DATE
Rev. for Tract 103	CUK-MLH	12-15-81
Rev. for Tract 104	VNG-MLH	5-11-81
Add Bea.	CUK-MLH	4-14-81
Void 701, 104, 705	CUK-WRH	3-10-81
Added Topog.	CUK-dds	11-20-80

FLORIDA DEPARTMENT OF TRANSPORTATION
RIGHT OF WAY ENGINEERING SECTION

RIGHT OF WAY MAP

STATE ROAD NO. 45 — LEE COUNTY

	BY	DATE	APPROVED BY	DATE
DRAWN	C.U.K.	2-28-80	C.W. Monts Jr.	
TRACED	K.R.W.	3-17-80	DISTRICT ENGINEER	
CHECKED	J.W.D.	5-14-80	W.A. Sullivan 11-4-80	
			ENGINEER OF RIGHT OF WAY	

MAPS PREPARED BY: FIRST DISTRICT
FIELD BOOK NO'S: 021538, 022779
W.P.I. NO. 114447
SCALE 1" = 50'
SECTION 12010 2906
SHEET 1

POLYTRACE 033

F.A. PROJECT NO. HES-301-2(12) | SHEET NO.

TABLE OF OWNERSHIPS

PARCEL NO.	SHEET NO.	NAME	AREA TAKEN	REMAINDERS RIGHT	REMAINDERS LEFT	COMMENTS
100.1	1	CITY OF FORT MYERS	359 SF	0	15936 SF	O.R. 1599, PG. 300
101.1	1	Norton A. Gosberry, Pers. Rep.	253 SF	0	13318 SF	
102.1	1	SUNRISE CO. OF CENTRAL FLORIDA	3153 SF	0	0.530 Ac.	O.R. 1639, PG. 1111
103.1	1	THE MOST REVEREND THOMAS N. LARKIN	2012 SF	0	20394 SF	
104.1	1	KEITH I. TAYLOR, et al	1539 SF	1.821 Ac.	0	O.R. 1634, PG. 340
105.1	1	FRANK C. ALDERMAN JR., et ux	2061 SF	14495 SF	0	O.R. 1647, PG. 2506
106.1	1	CONSTANCE N. NEWMAN	1586 SF	7025 SF	0	
107.1	1	LEE COUNTY BANK	1789 SF	14357 SF	0	

PARCEL NO.	SHEET NO.	NAME	AREA TAKEN	REMAINDERS RIGHT	REMAINDERS LEFT	COMMENTS
~~700.1~~	~~1~~	~~JAMES H. McNEIL~~	~~2065 SF~~	~~(Area of Grant Tract (8158 SF))~~		~~Temporary Const Esmt~~ VOID
~~701.1~~	~~1~~	~~KEITH I. TAYLOR et al~~	~~893 SF~~	~~(See Parcel~~	~~104.1)~~	~~Temporary Const Esmt~~ VOID
~~702.1~~	~~1~~	~~CONSTANCE N. NEWMAN~~	~~338 SF~~	~~(See Parcel~~	~~106.1)~~	~~Temporary Const Esmt~~ VOID

PARCEL NO.	SHEET NO.	NAME	AREA TAKEN	REMAINDERS RIGHT	REMAINDERS LEFT	COMMENTS

REVISION	BY	DATE
Rev Area Rem 103	CJR-MLH	12-15-81
Rev Area Rem 104	JMD-MLH	3-11-81
Name Chg. 103	CJR-MLD	4-14-81
Add Par. 700, 701, 702	CJR-MLH	5-10-81
Name Chg. 101	CJR-MLD	6-13-81

FLORIDA DEPARTMENT OF TRANSPORTATION
RIGHT OF WAY ENGINEERING SECTION

RIGHT OF WAY MAP

STATE ROAD NO. 45 — LEE COUNTY

	BY	DATE	APPROVED BY	DATE
DRAWN	C.U.K.	10-13-80	C. W. Mont De Oca	
TRACED			DISTRICT ENGINEER	
CHECKED			W. A. Stephens	11-4-80
MAP PREPARED BY			CHIEF ENGINEER OF RIGHT OF WAY	
FIRST DISTRICT			FIELD BOOK NO'S	
W.P.I. NO. 114447			SCALE	
SECTION 12010-2906			SHEET 2 OF	

POLYTRACE 033