FED. ROAD DIV.	ROAD NO.	STATE	PROJECT NO.	SECTION YEAR	SHEET NO.
3		FLA.	12560-2604		1

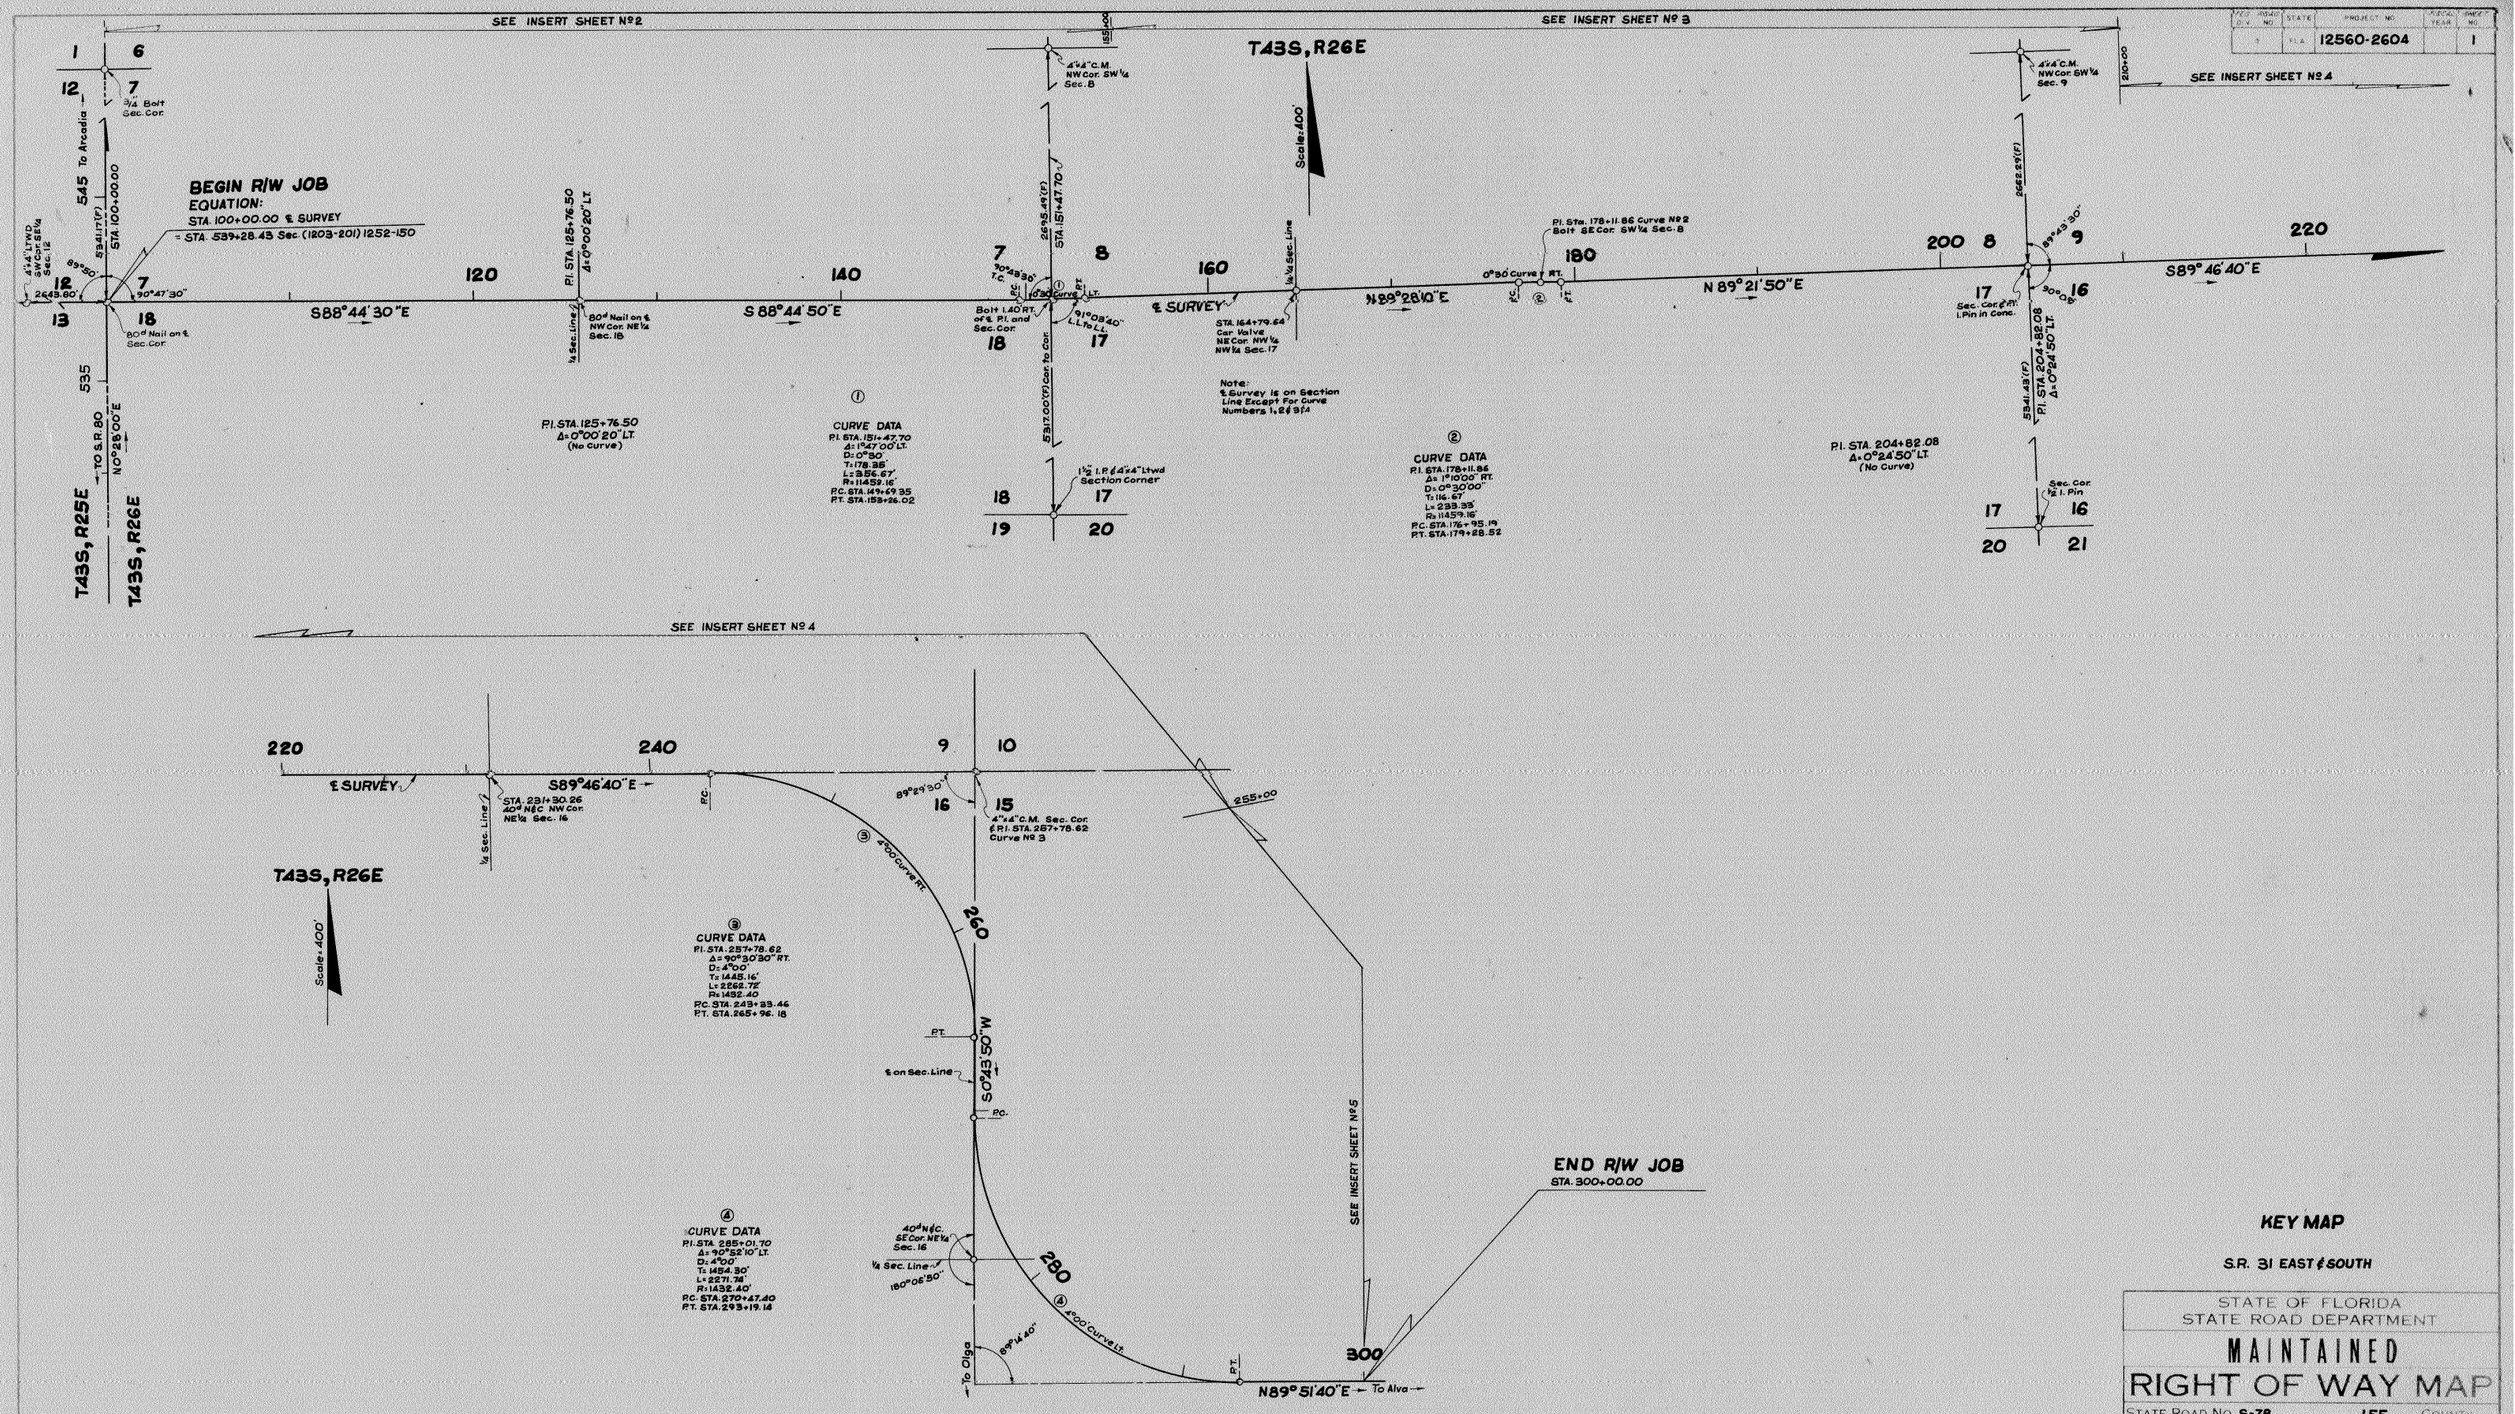

KEY MAP

S.R. 31 EAST & SOUTH

STATE OF FLORIDA
STATE ROAD DEPARTMENT

MAINTAINED RIGHT OF WAY MAP

STATE ROAD NO. S-78 LEE COUNTY

	BY	DATE	APPROVED BY	DATE
DRAWN			H. M. Johnson	
TRACED	L.R.J.	7-9-65		
CHECKED				
COMPARED	DC	7-20-65		
INDEXED				

SECTION 12560-2604 SHEET 1 OF

THIS IS TO CERTIFY that the within and attached sheets numbered one (1) to 5, inclusive, constitute a true copy of the official Right of Way Map showing location and survey by the State Road Department of Florida for a portion of State Road S-78 designated as Section 12560 in Lee Co., Florida.

THE PROPERTY outlined in RED ink on the said sheets has been vested in the State Road Department of Florida, pursuant to the provisions of Section 341.50 Florida Statutes of 1951 and Section 337.31 Florida Statutes of 1955, and/or under formal conveyance and other instruments.

IN WITNESS WHEREOF, We have hereunto set our hands and affixed the seal of the State Road Department of Florida, at Tallahassee, Florida, this 3rd day of Sept. A.D. 1965

Ralph Davis
Executive Director, State Road Department of Florida

F. K. Strickland
Secretary, State Road Department of Florida

ACCEPTED for files and recorded in the Public Records of _____ Co., Florida, this _____ day of _____ A.D. 19__, in Road Plat Book _____ Page _____

Clerk of Circuit Court of _____ Co., Florida

FED. ROAD DIV. NO.	ROAD NO.	STATE	PROJECT NO.	FISCAL YEAR	SHEET NO.
4	S-78	FLA.	12560-2604		2

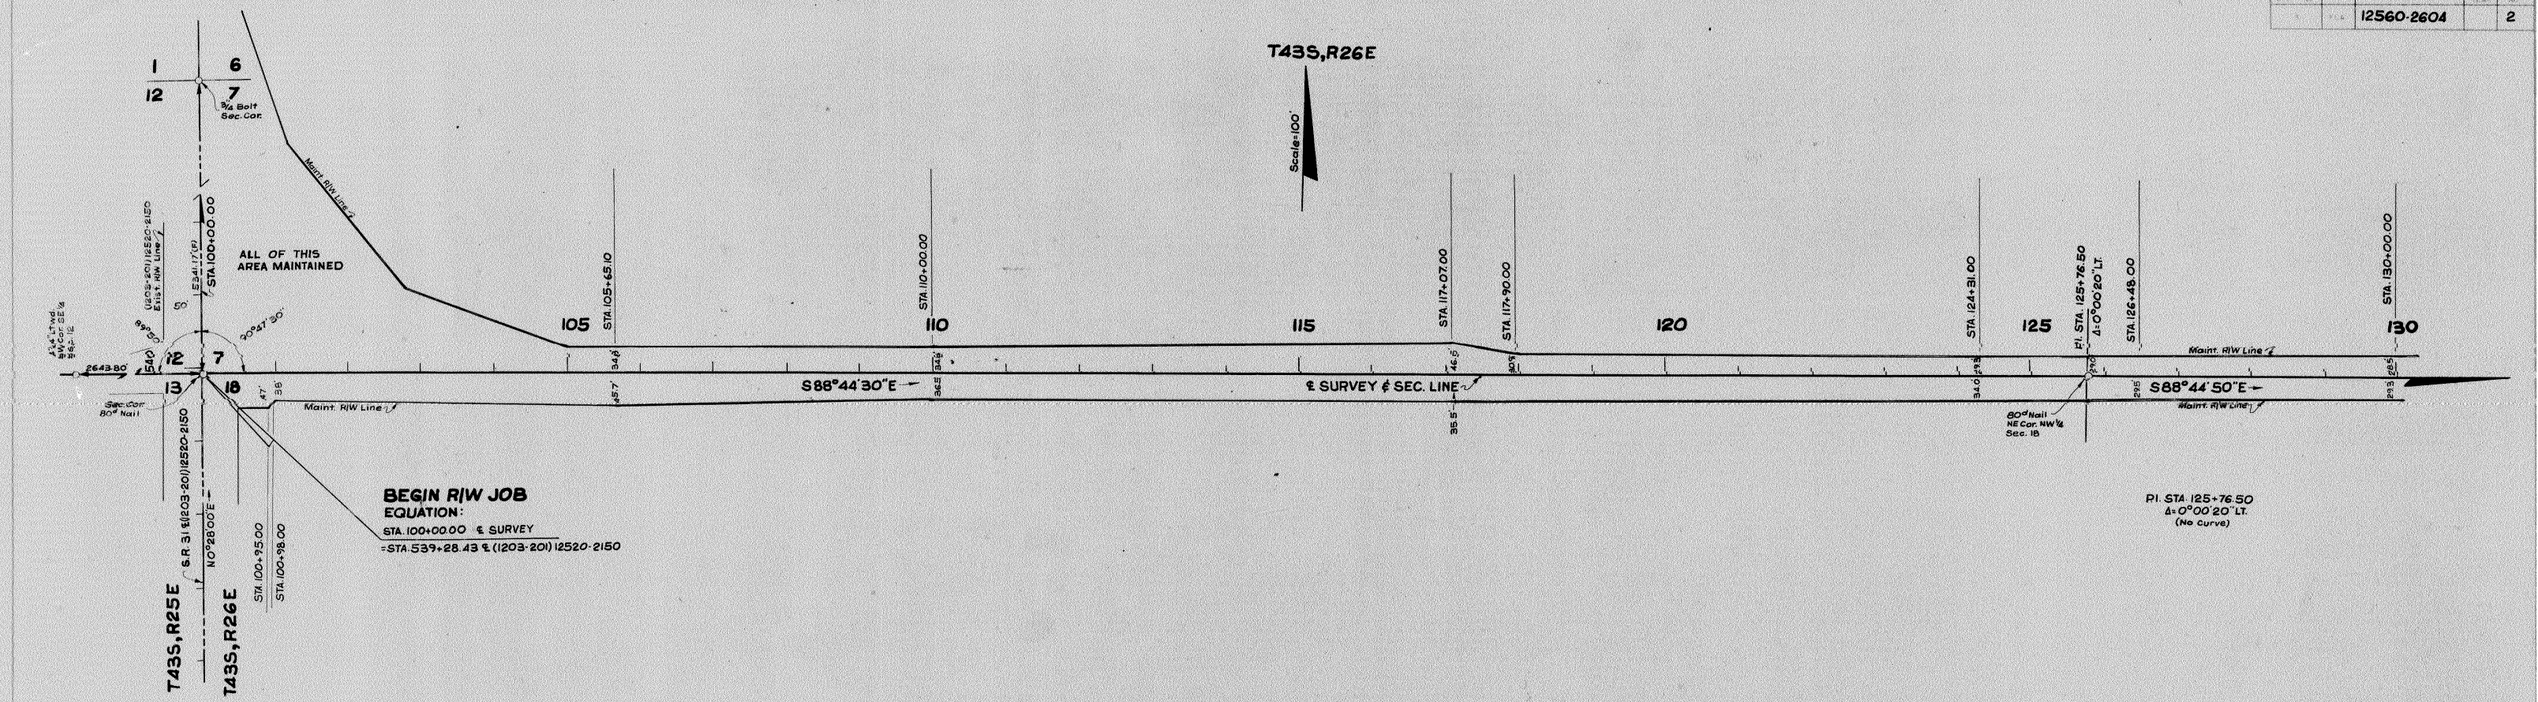

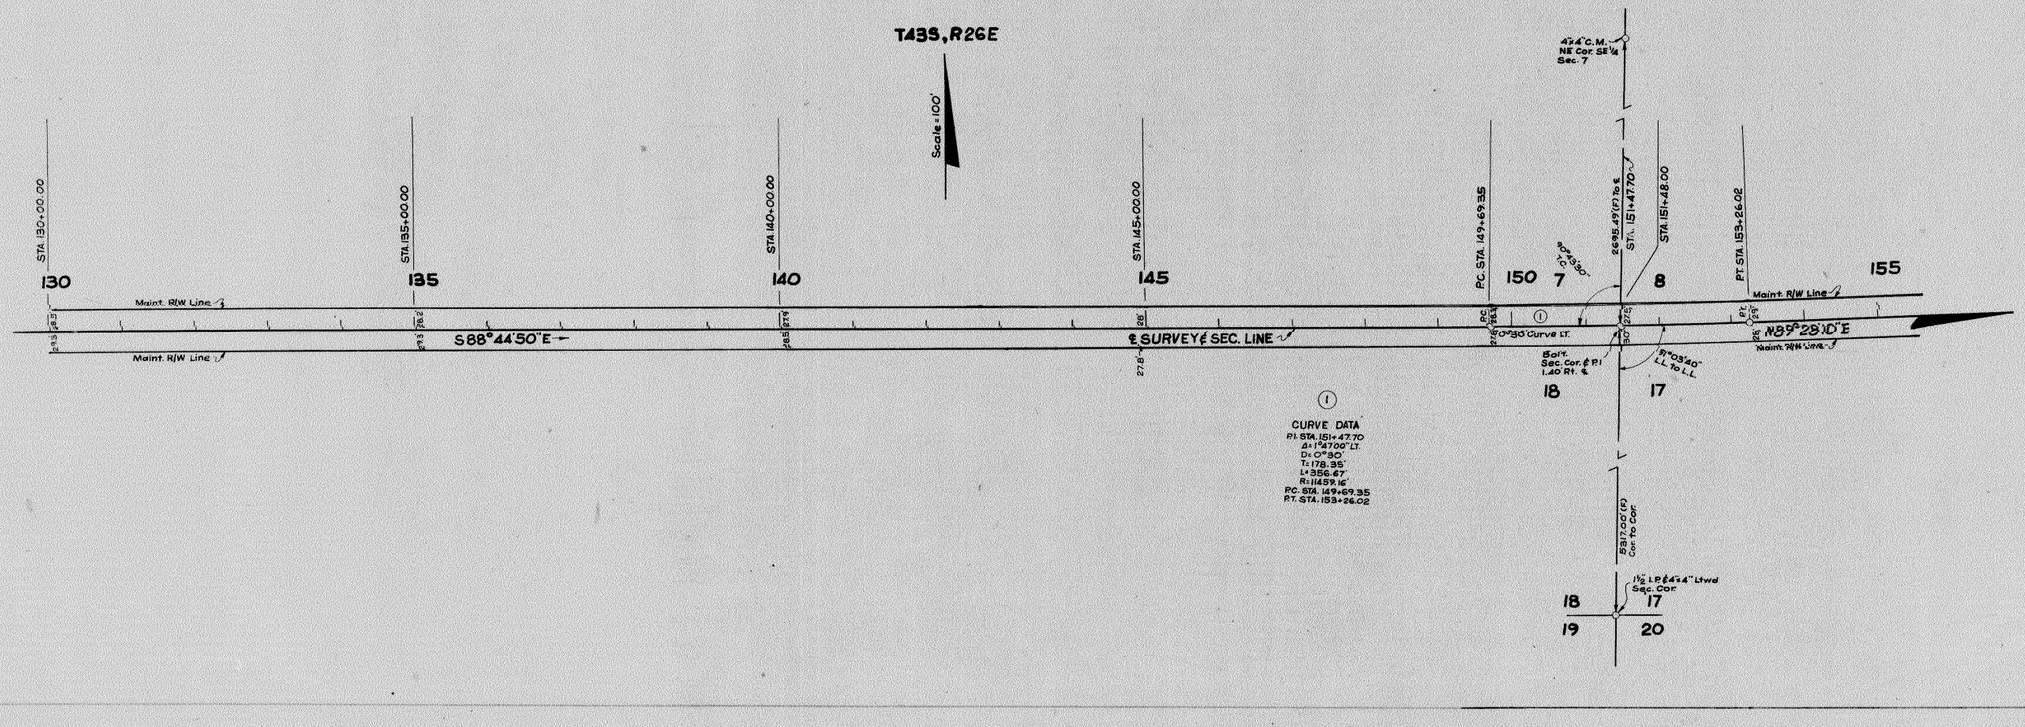

INSERT

(F) Indicates Field Dimension

STATE OF FLORIDA
STATE ROAD DEPARTMENT

MAINTAINED RIGHT OF WAY MAP

STATE ROAD NO. S-78 LEE COUNTY

	BY	DATE	APPROVED BY	DATE
DRAWN	L.R.J.	7-12-65	H. M. Johnson	
TRACED				
CHECKED				
COMPARED	D.C.	7-20-65		
INDEXED				

SECTION 12560-2604 SHEET 2 OF

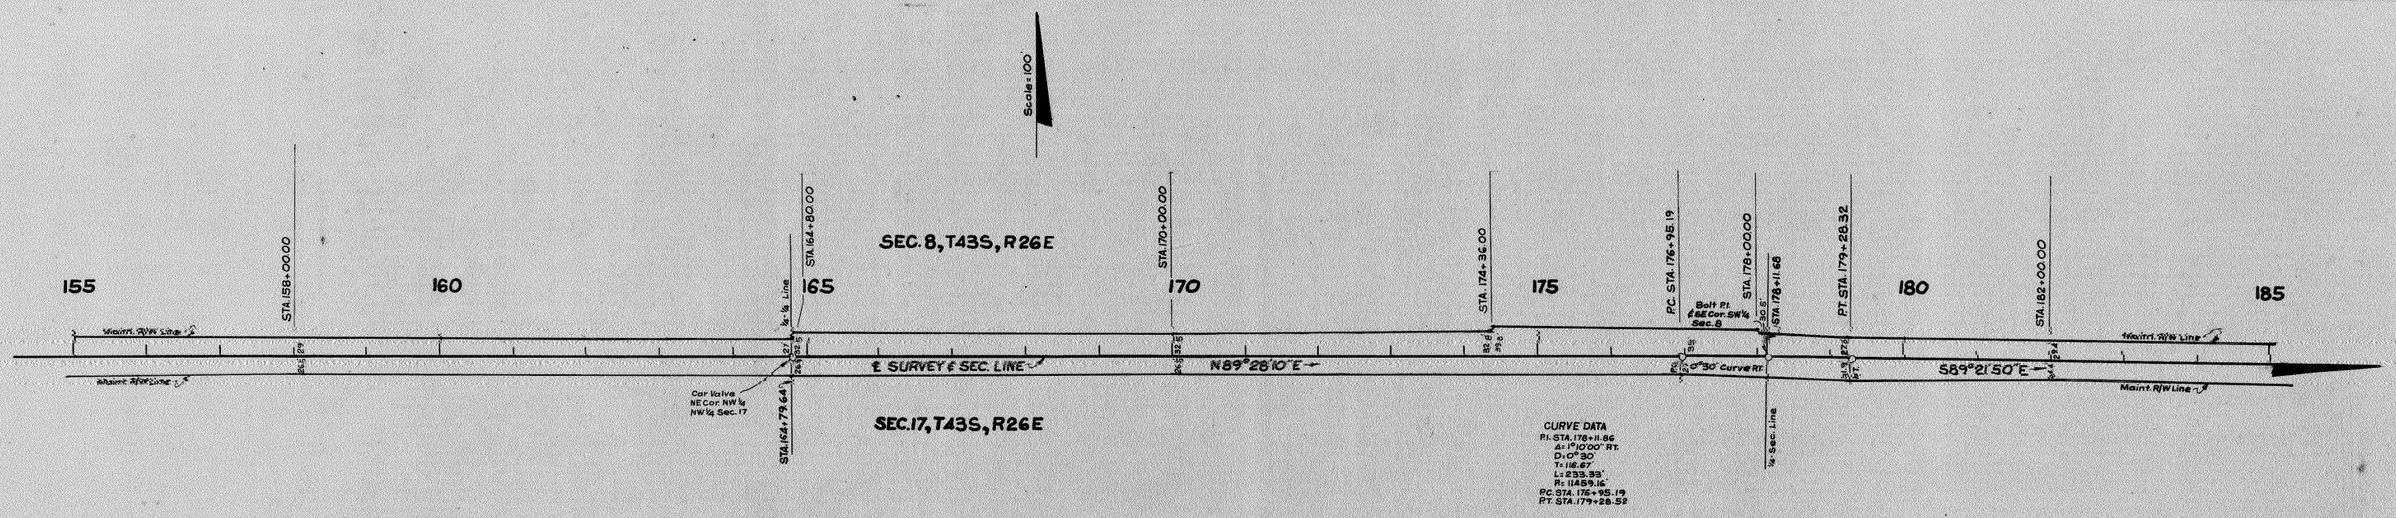

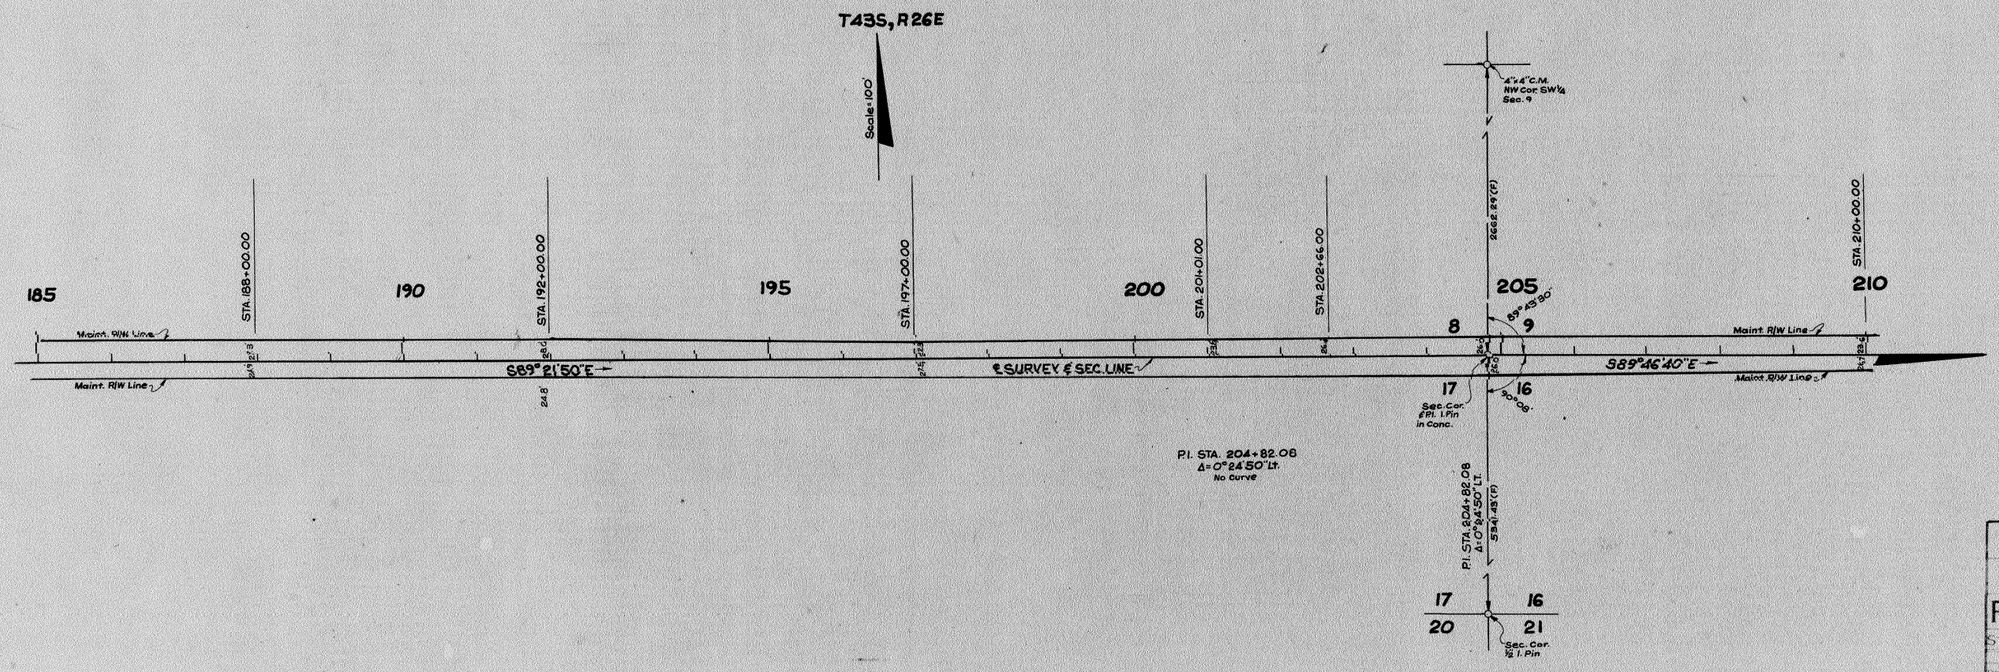

INSERT

(F) Indicates Field Dimension

STATE OF FLORIDA
STATE ROAD DEPARTMENT

MAINTAINED RIGHT OF WAY MAP

STATE ROAD NO. S-78 LEE COUNTY

	BY	DATE	APPROVED BY	DATE
DRAWN	L.R.J.	7-12-65	E. M. Johnson	
TRACED			DISTRICT ENGINEER	
CHECKED				
COMPARED	D.C.	7-20-65		
INDEXED			STATE HIGHWAY ENGINEER	

SECTION 12560-2604 SHEET 3 OF

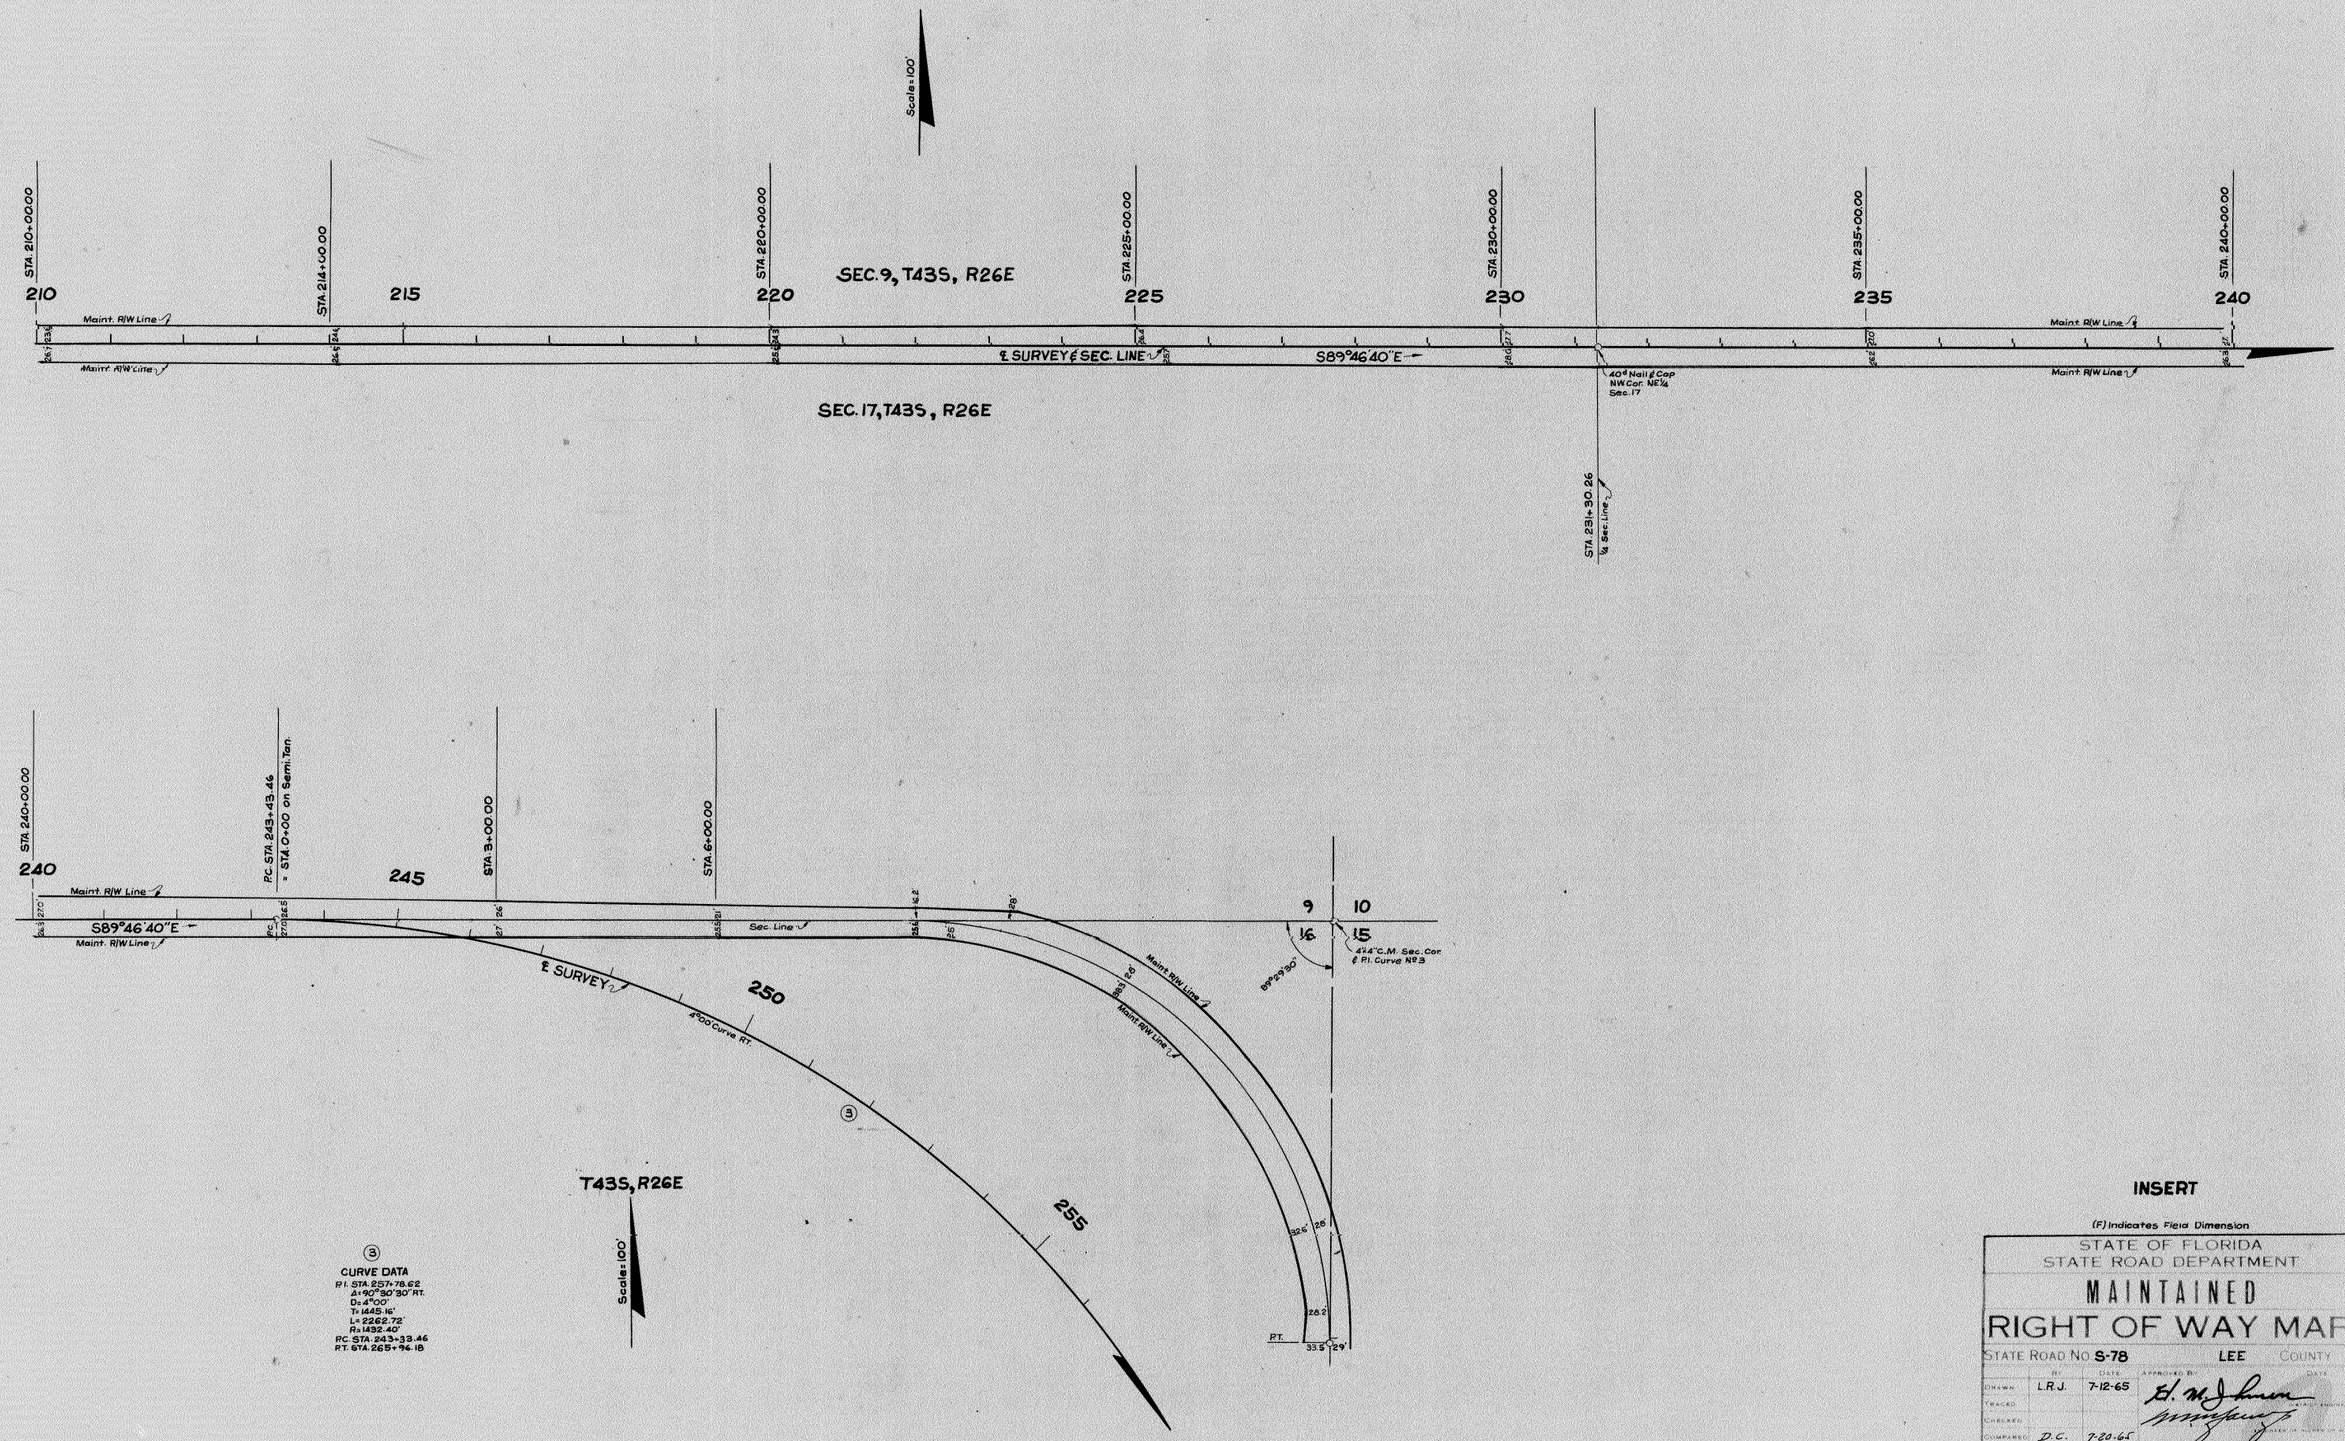

INSERT

(F) Indicates Field Dimension

STATE OF FLORIDA
STATE ROAD DEPARTMENT

MAINTAINED RIGHT OF WAY MAP

STATE ROAD NO. S-78 LEE COUNTY

	BY	DATE	APPROVED BY	DATE
DRAWN	L.R.J.	7-12-65	H. M. Johnson	
TRACED				
CHECKED				
COMPARED	D.C.	7-20-65		
INDEXED				

SECTION 12560-2604 SHEET 4 OF

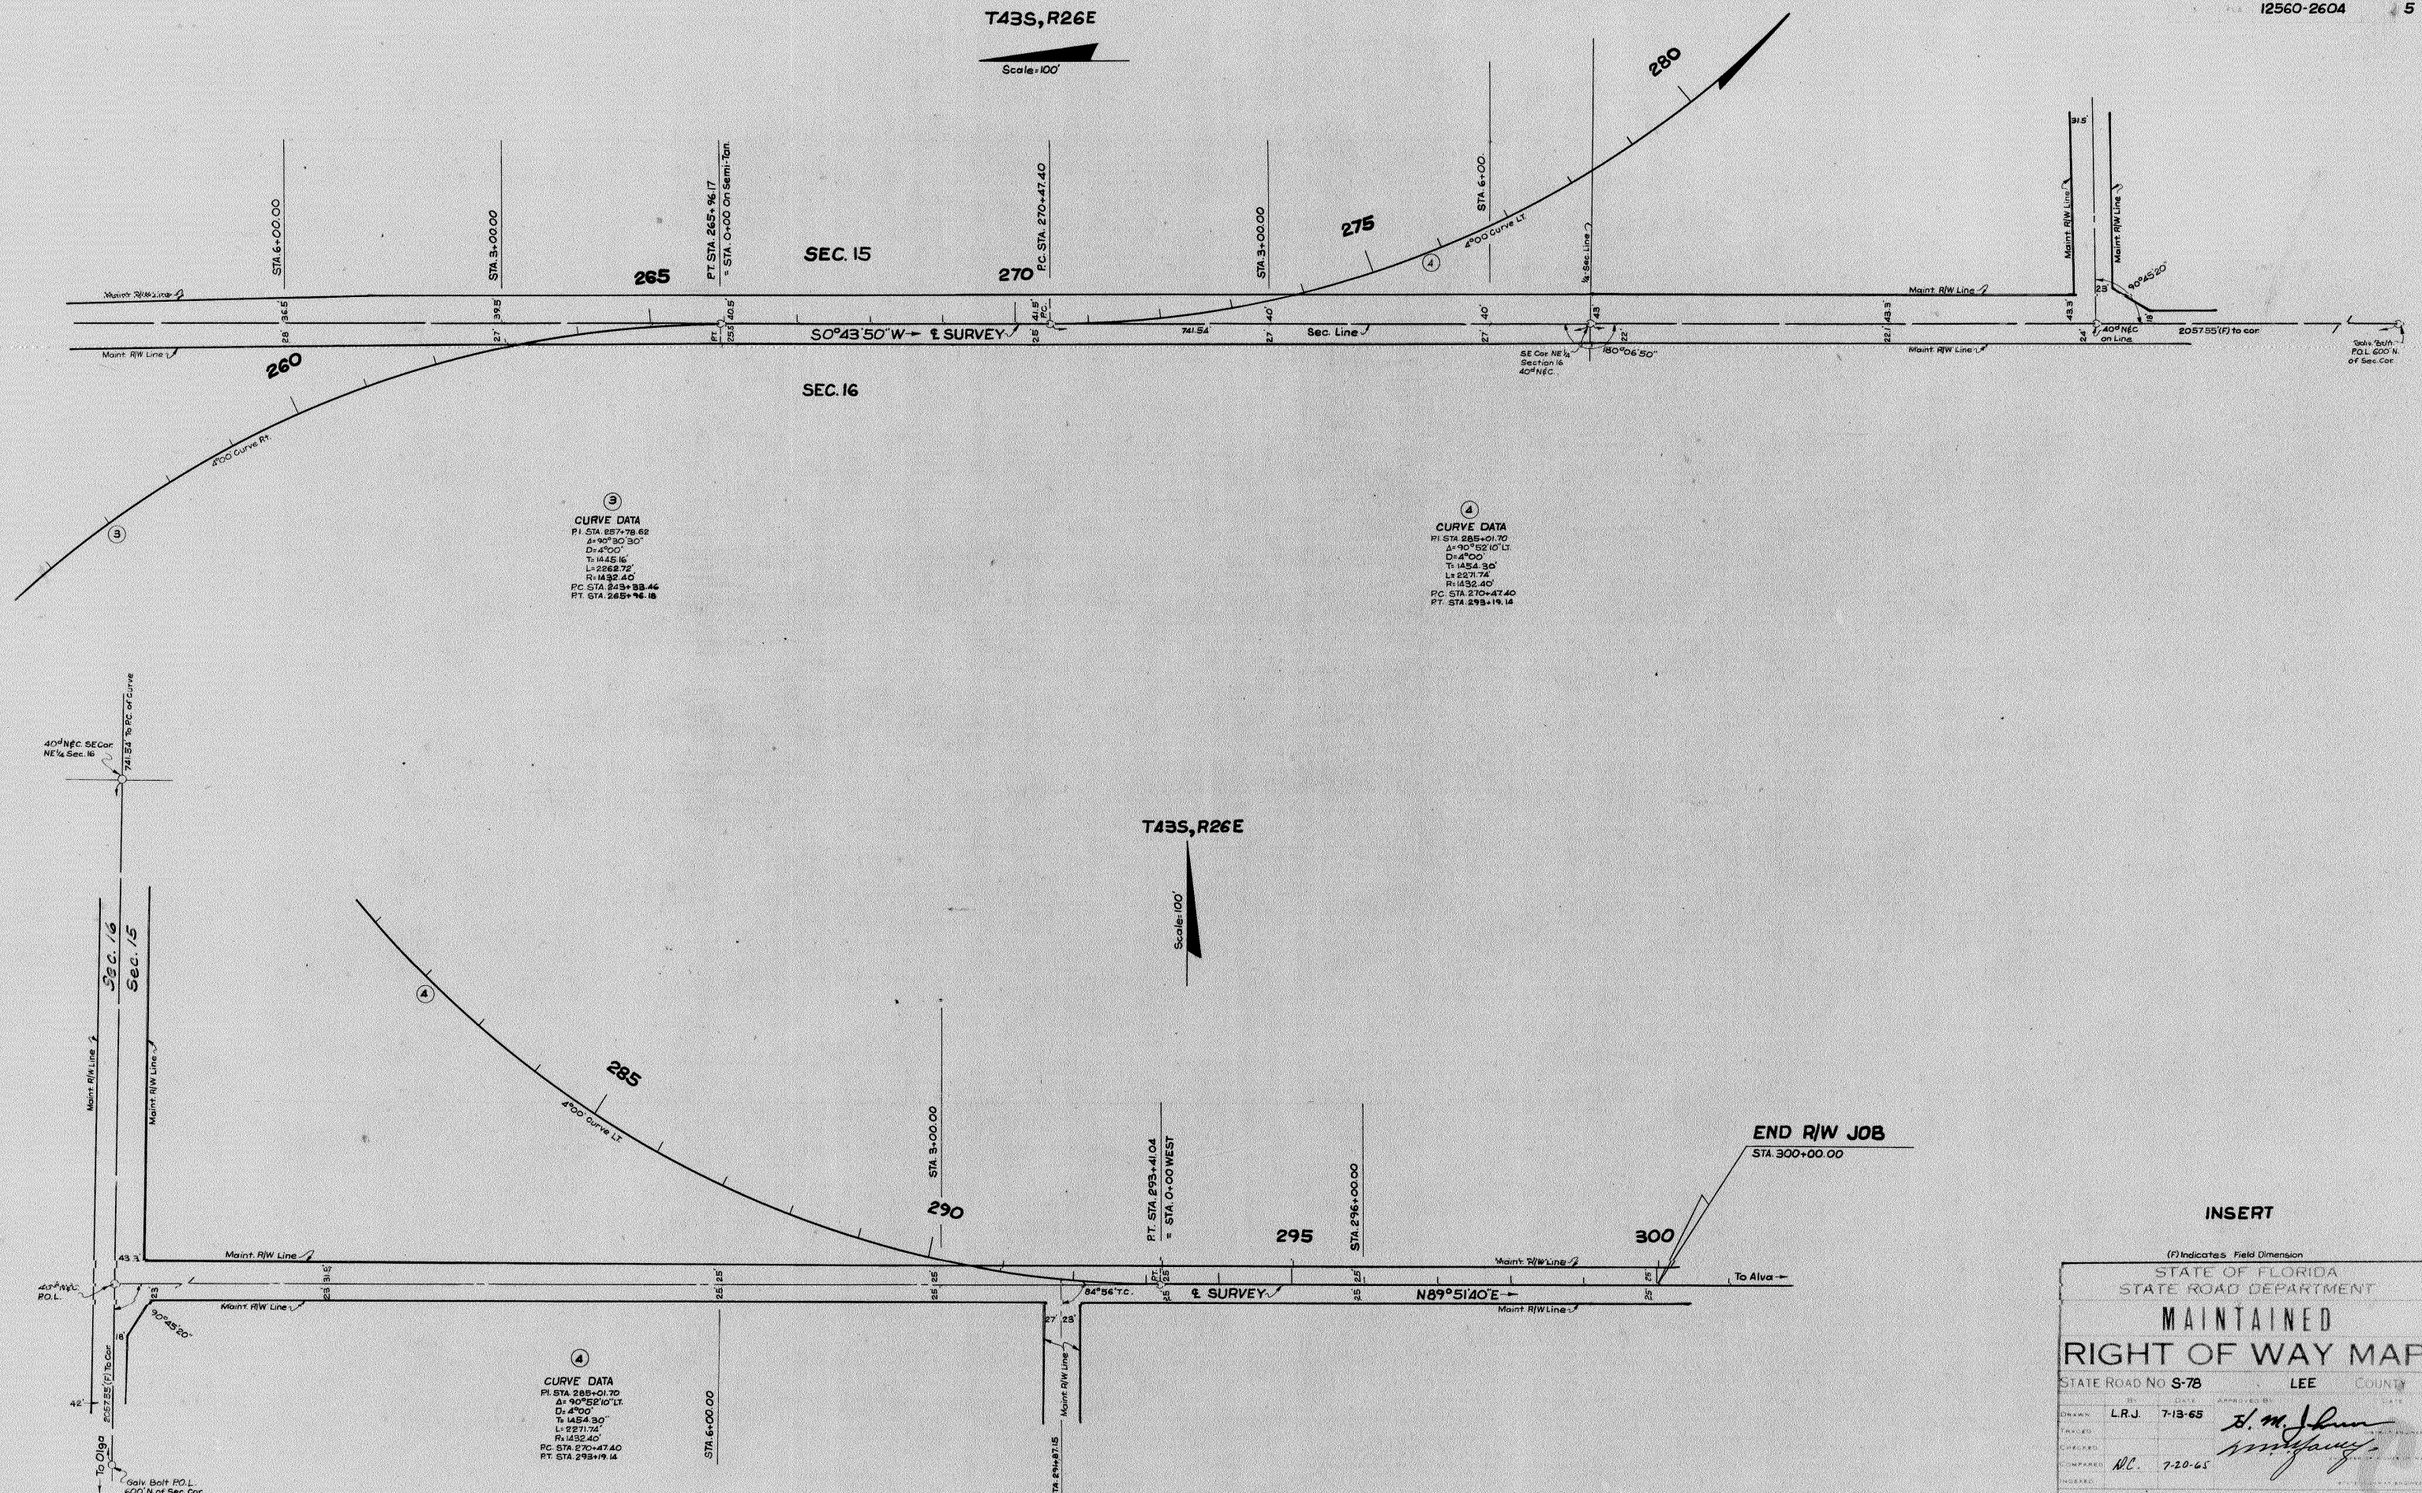

INSERT

(F) Indicates Field Dimension

STATE OF FLORIDA
STATE ROAD DEPARTMENT

MAINTAINED RIGHT OF WAY MAP

STATE ROAD NO. S-78 LEE COUNTY

	BY	DATE	APPROVED BY	DATE
DRAWN	L.R.J.	7-13-65		
TRACED				
CHECKED				
COMPARED	N.C.	7-20-65		
INDEXED				

SECTION 12560-2604 SHEET 5 OF