FED. ROAD DIV. No.	STATE	PROJECT No.	FISCAL YEAR	SHEET No.
3	FLA.	47501-2608	68	1

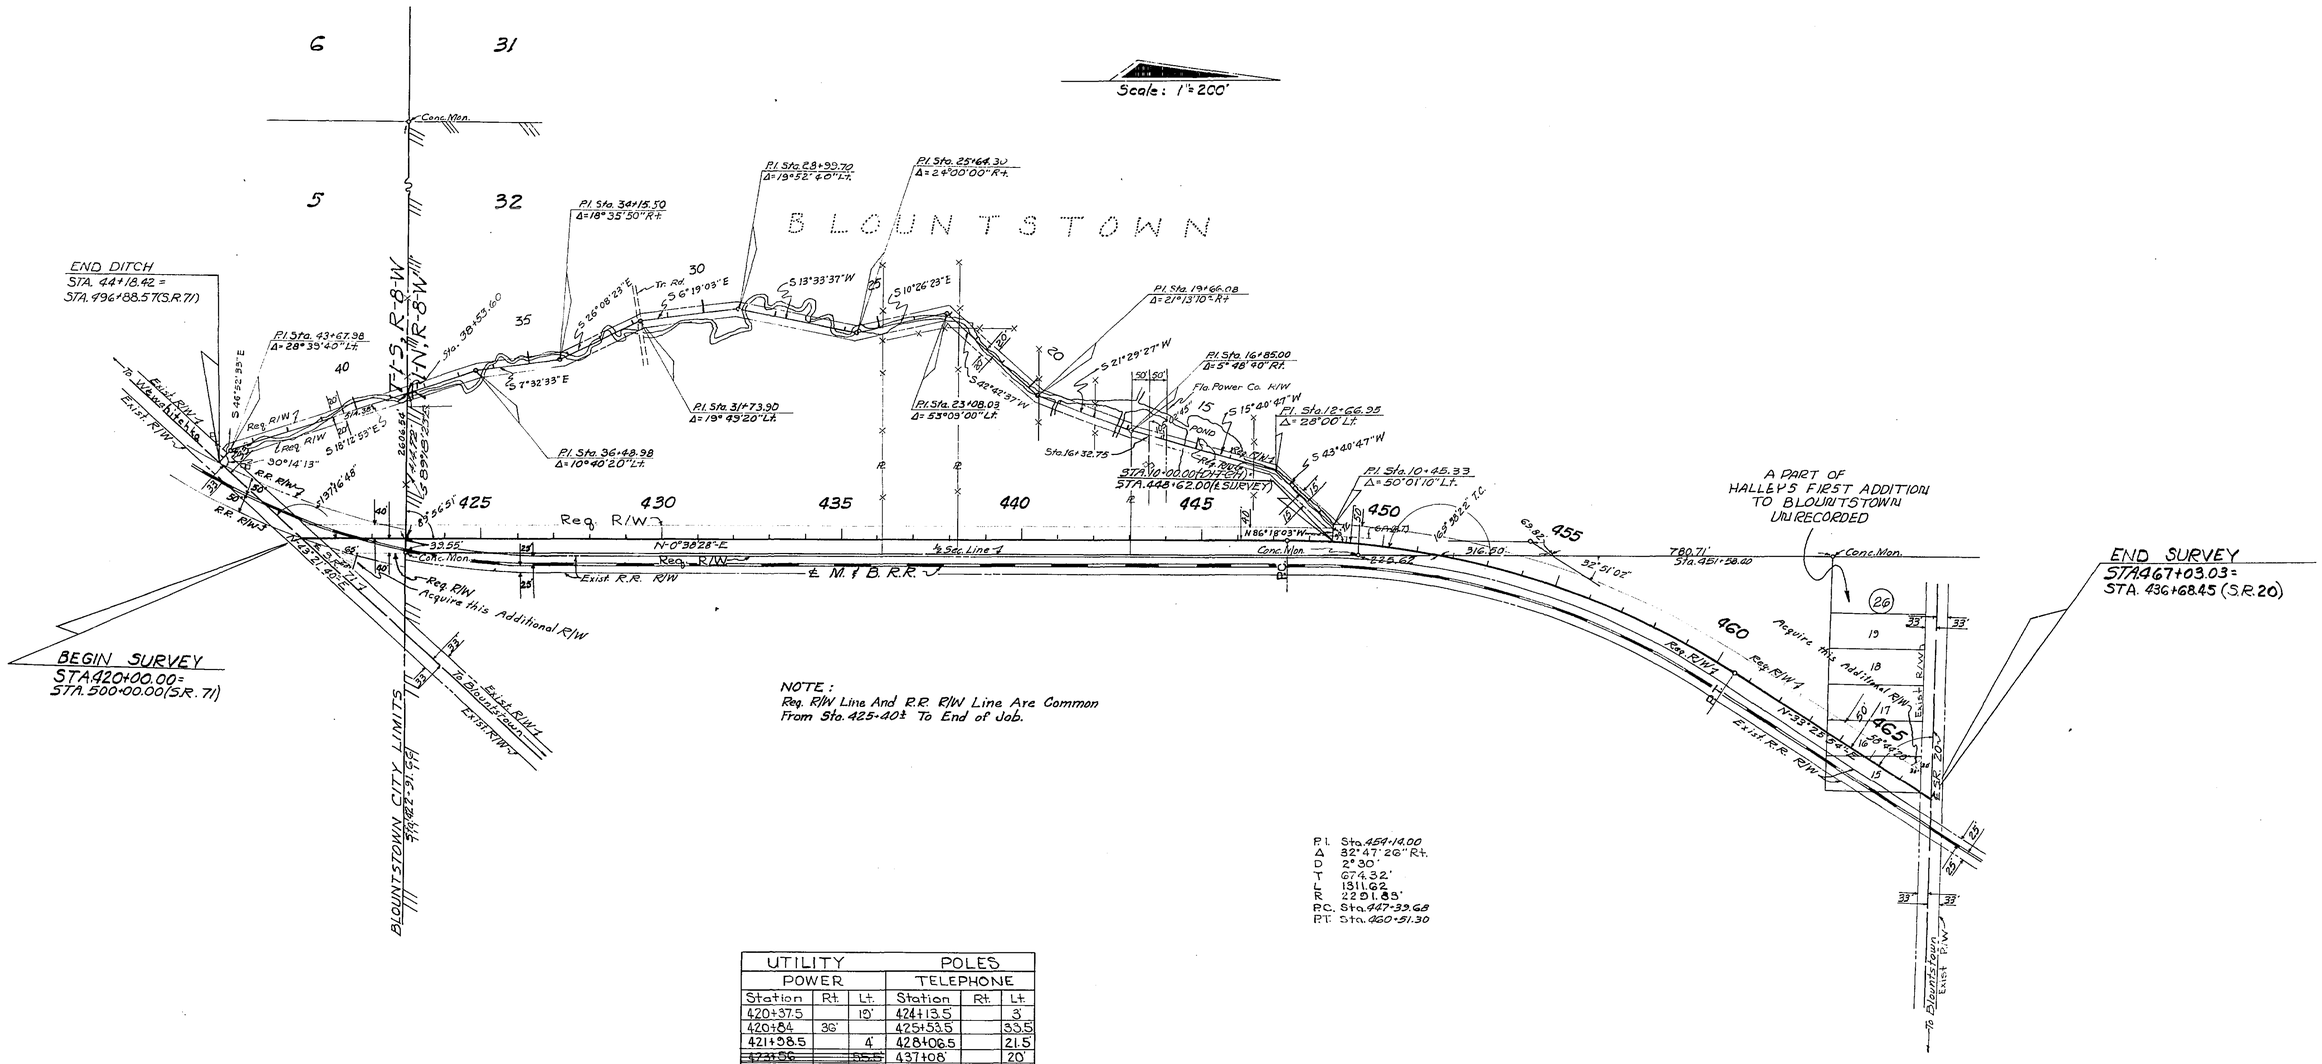

NOTE:
Req. R/W Line And R.R. R/W Line Are Common From Sta. 425+40± To End of Job.

P.I. Sta. 454+14.00
Δ 32°47'26" Rt.
D 2°30'
T 674.32'
L 1311.62
R 2291.83'
P.C. Sta. 447+39.68
P.T. Sta. 460+51.30

UTILITY POLES					
POWER			TELEPHONE		
Station	Rt.	Lt.	Station	Rt.	Lt.
420+37.5		19'	424+13.5		3'
420+84	36'		425+53.5		33.5
421+98.5		4'	428+06.5		21.5'
~~423+56~~		~~55.5~~	437+08		20'
~~425+66~~		~~53'~~	~~440+15~~		~~112'~~
427+25.5		34'	461+80		35'
~~427+82.5~~		~~73'~~	463+58.5		26'
427+88.5	21.5'		465+47.5		22.5'
431+20.5		17'	466+42		46.4'
435+01		20'			
437+08		20'			
439+91.5		22.5			
~~440+15~~		~~112'~~			

Note: For Borrow Pit No. 1-A to be used on this Job, See Sheet No. 1 on Job No. 47501-2606

UTILITY OWNERS

Power Poles sta 420+0 to sta 423+56 : City of Blountstown
Power Poles Sta. 425+66 to Sta 440+15 : Florida Public Utilities
Telephone Poles : St. Joseph Telephone Co.

STATE OF FLORIDA
STATE ROAD DEPARTMENT

RIGHT OF WAY MAP

STATE ROAD No. CALHOUN COUNTY

	BY	DATE	APPROVED BY	DATE
DRAWN				
TRACED	J.W.	12-12-68		DISTRICT ENGINEER
CHECKED				ENGINEER OF RIGHTS OF WAY
COMPARED				
INDEXED				STATE HIGHWAY ENGINEER

REVISION	BY	DATE
Section tie	BW-RPH	10-28-76
Bearings	BW	9-29-76
Ditch	JP	7-22-76
Rev. note	BW-MHC	3-12-69
	JW-MHC	2-26-69
Subd. & note	DV-MHC	2-5-69

SECTION. 47501-2608 SHEET 1 OF 1

CHIPOLA ROAD ~ FROM S.R. 71 - TO S.R. 20

A. R. COGSWELL, JACKSONVILLE, FLORIDA — 1ST LINEN —