FED. ROAD DIST. No.	STATE	~~FED. AID~~ PROJ. No.	FISCAL YEAR	SHEET NO.	TOTAL SHEETS
8	FLA.	5201-203	46	1	3

Job

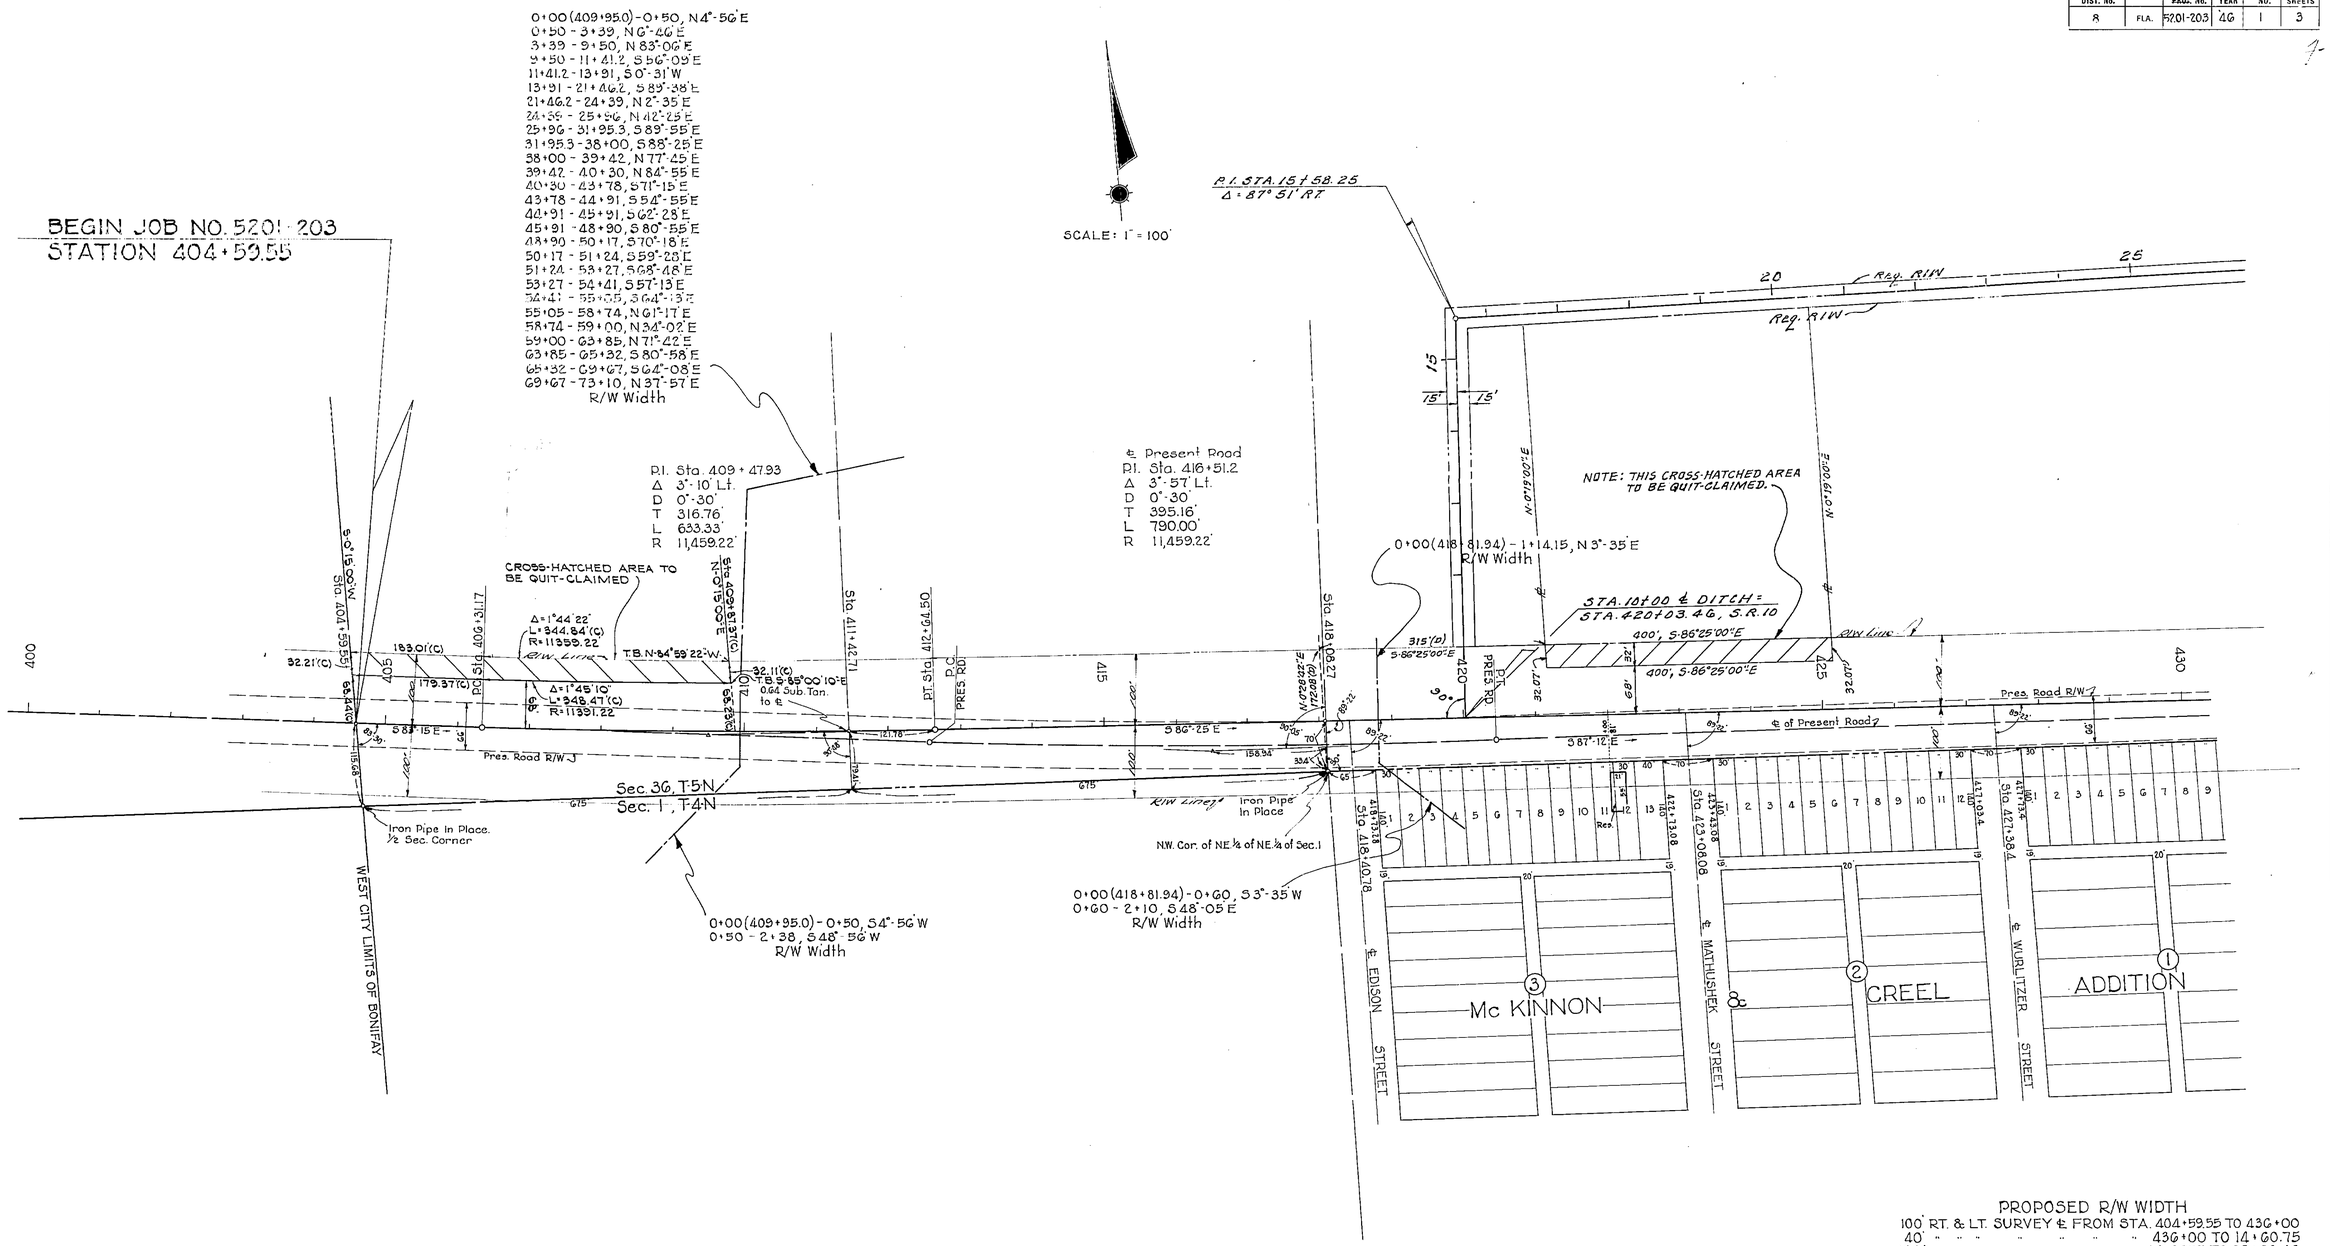

PROPOSED R/W WIDTH
100' RT. & LT. SURVEY ℄ FROM STA. 404+59.55 TO 436+00
40' " " " " " " " 436+00 TO 14+60.75
100' " " " " " " " 14+60.75 TO 39+09.43

State Road 10 — STATE OF FLORIDA
STATE ROAD DEPARTMENT

RIGHT OF WAY MAP

JOB NO. 5201-203, ROAD(1) HOLMES COUNTY

	Names	Dates	Approved by
Designed			Bridge Engineer
Drawn			
Traced	W. P.	8-27-46	State Highway Engineer
Checked			Drawing / Index No.
Revised	JMSC-T.D.W. I.C.	11-14-66 7-8-65	

BW 1-11-85

FED. ROAD DIST. No.	STATE	Job ~~FED. AID~~ ~~PROJ.~~ No.	FISCAL YEAR	SHEET NO.	TOTAL SHEETS
8	FLA.	5201-203	46	2	3

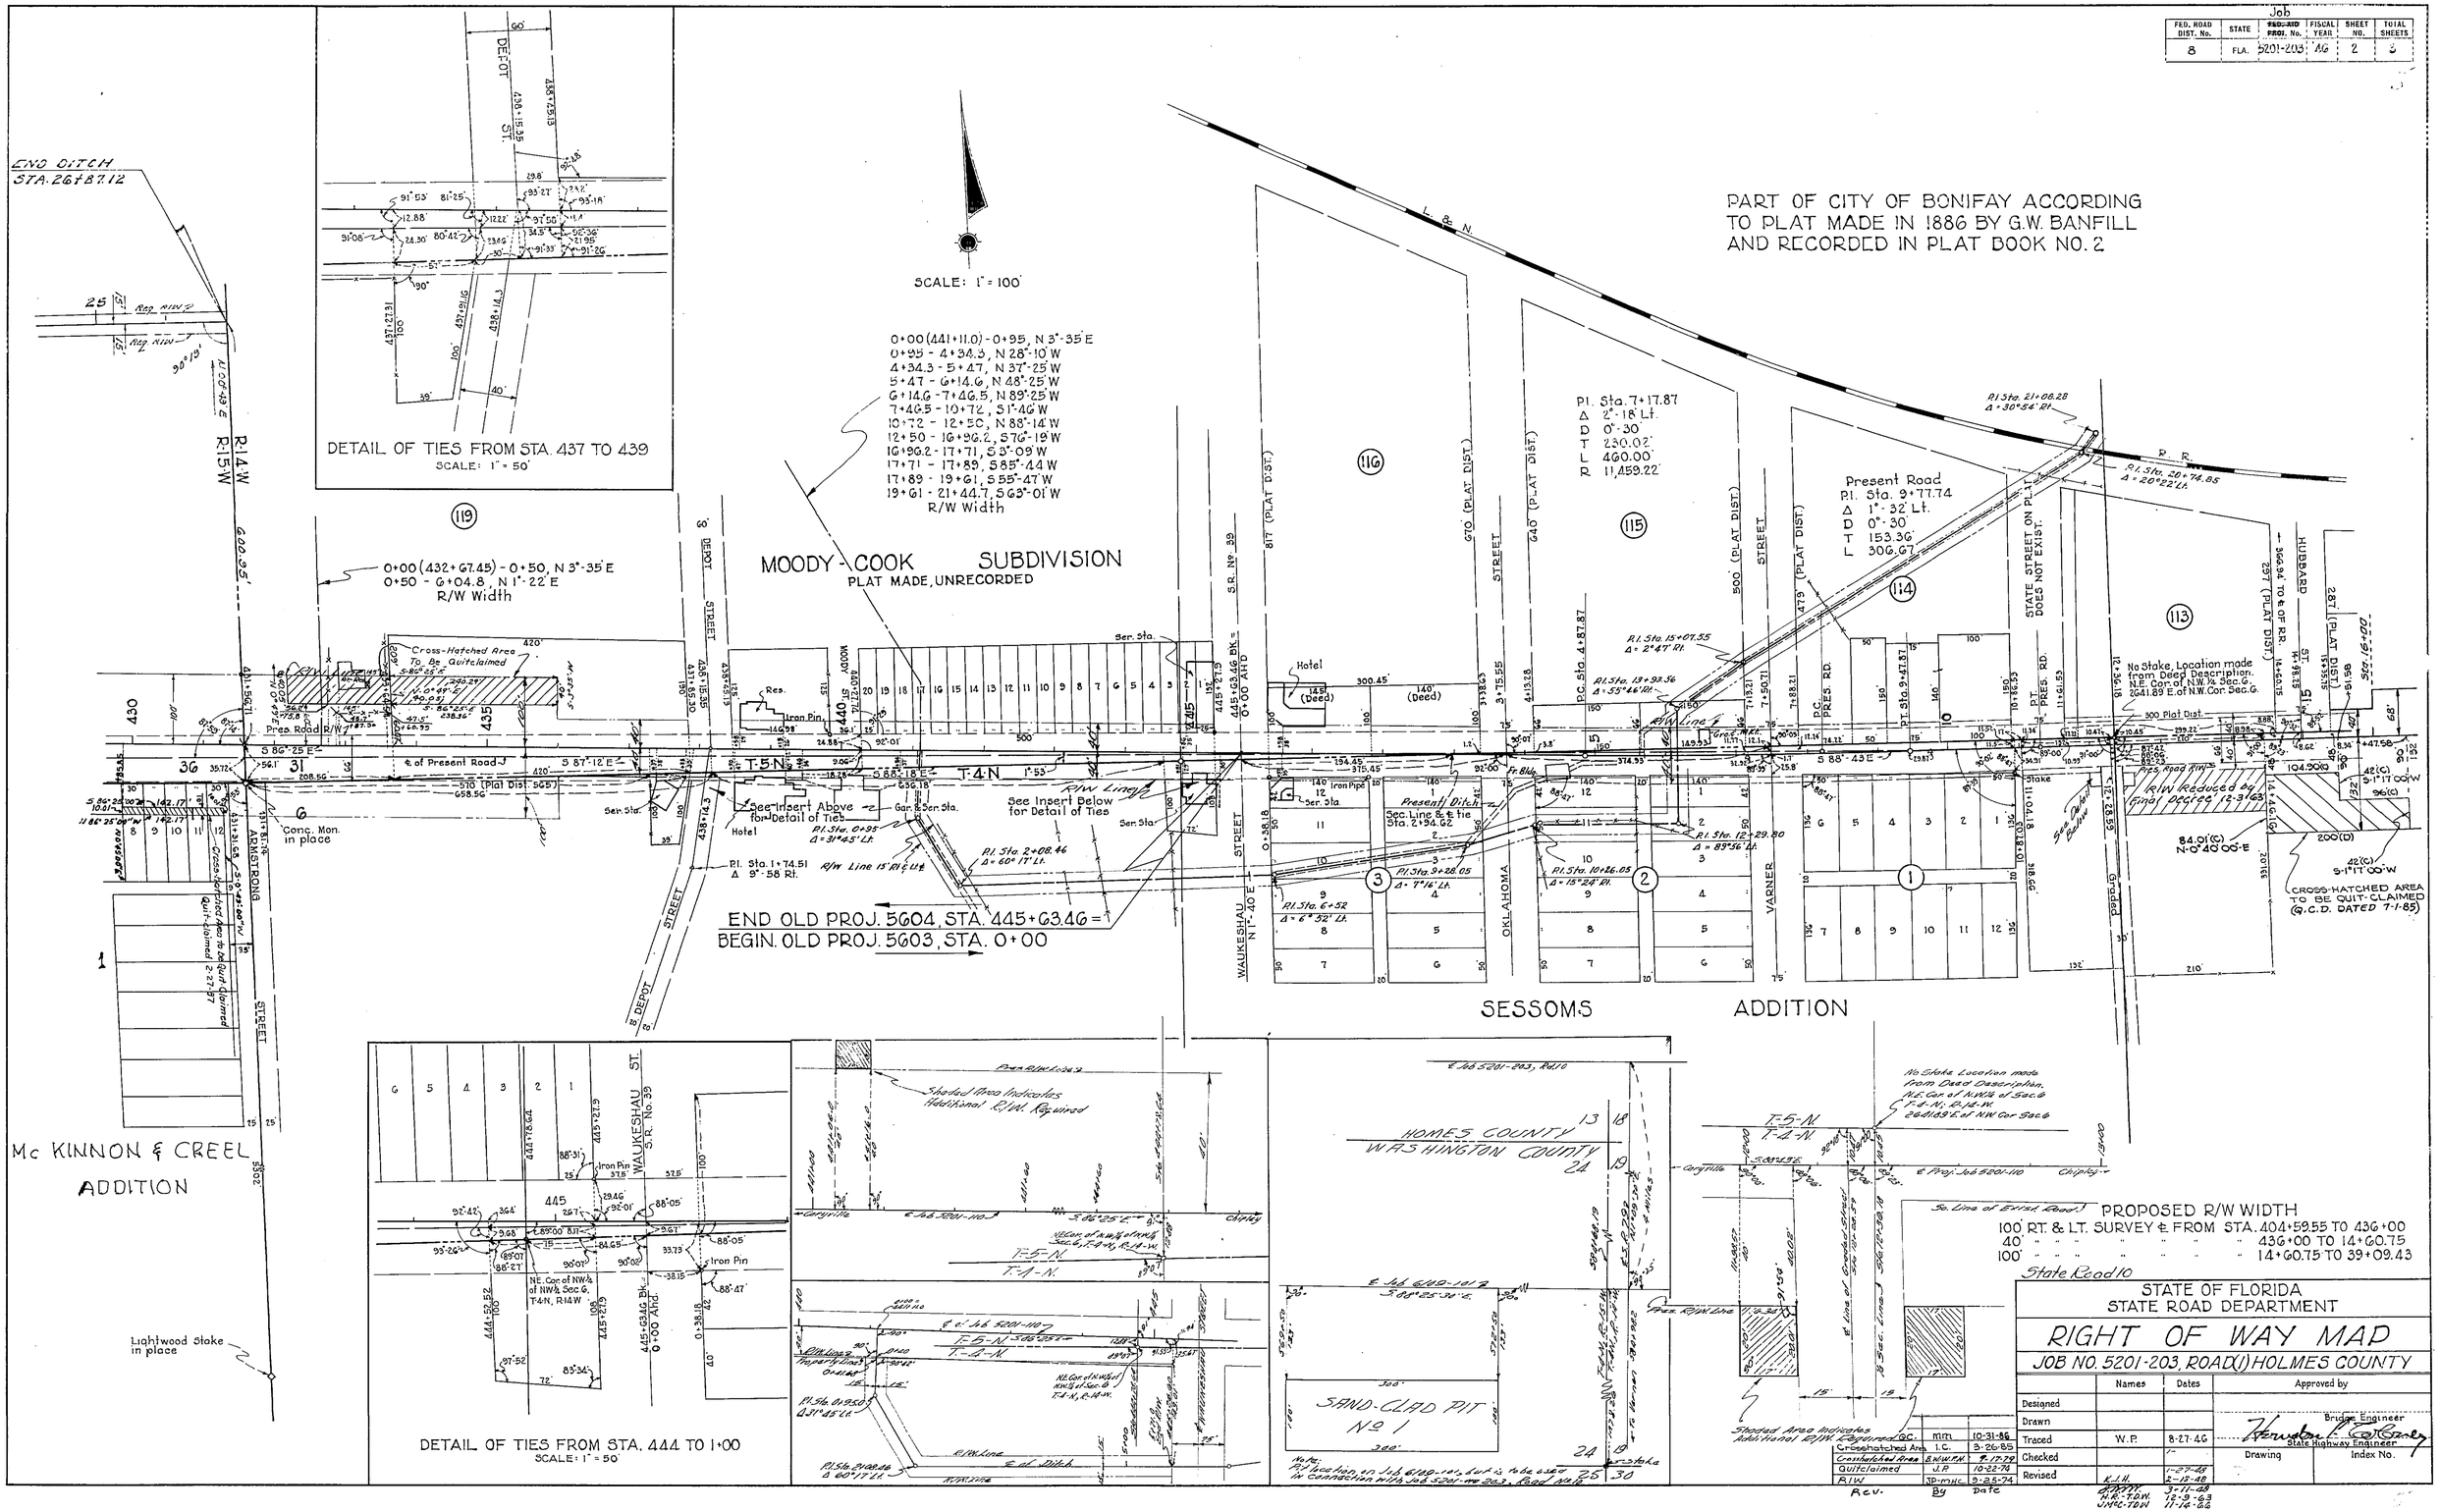

FED. ROAD DIST. No.	STATE	~~FED. AID~~ Job ~~PROJ.~~ No.	FISCAL YEAR	SHEET NO.	TOTAL SHEETS
8	FLA.	5201-203	46	3	3

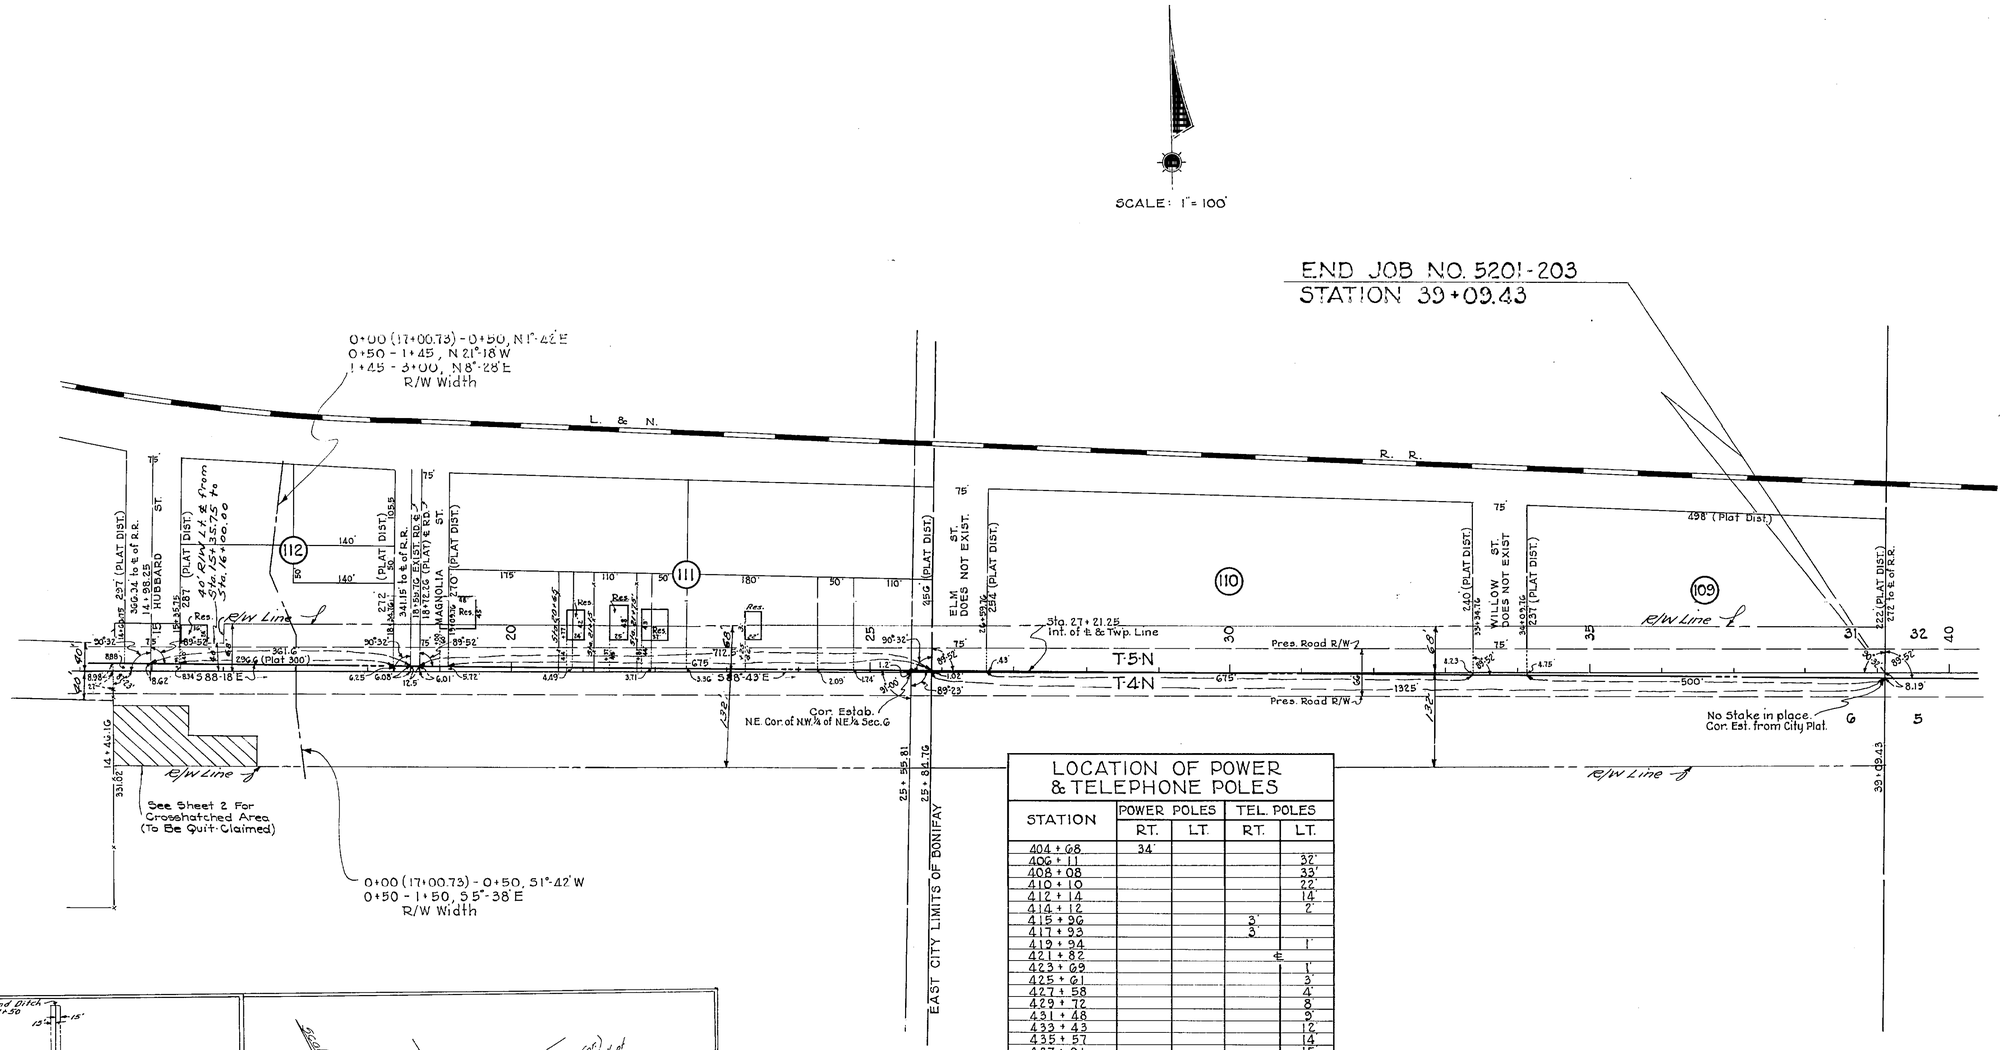

LOCATION OF POWER & TELEPHONE POLES

STATION	POWER POLES RT.	POWER POLES LT.	TEL. POLES RT.	TEL. POLES LT.
404+68	34'			
406+11				32'
408+08				33'
410+10				22'
412+14				14'
414+12				2'
415+96			3'	
417+93			3'	
419+94				1'
421+82			℄	
423+69				1'
425+61				3'
427+58				4'
429+72				8'
431+48				9'
433+43				12'
435+57				14'
437+91				15'
437+91				24'
438+39				14'
438+39		19'		
439+70				18'
441+59				27'
442+89				28'
443+91	31'			
444+40				18'
445+38	30'			
0+28		34'		
1+78	28'			
1+92				35'
3+46	24'			
5+87	24'			
7+21				38'
7+24	25'			
7+96	25'			
9+54				36'
10+20	32'			
12+51	41'			
13+20		32'		
15+27	32'	36'		
18+29	34'			
18+32		32'		
20+19		33'		
22+26		34'		
24+52		34'		
26+76		33'		
29+41		35'		

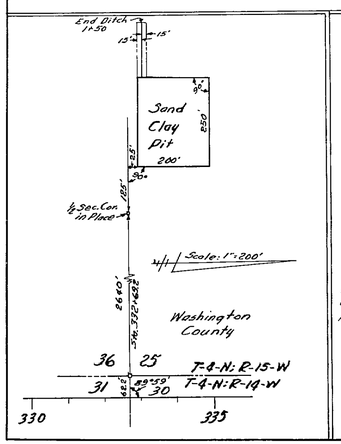

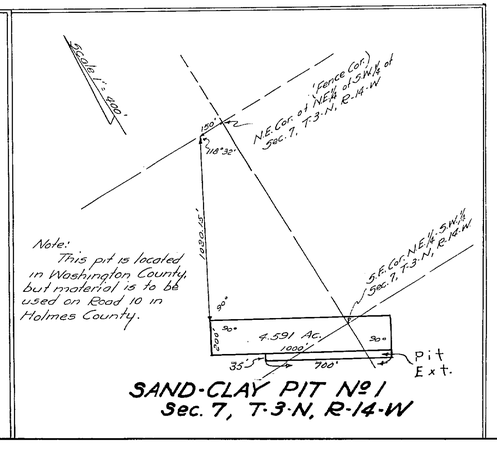

Note: This pit is located in Washington County, but material is to be used on Road 10 in Holmes County.

SAND-CLAY PIT No 1
Sec. 7, T-3-N, R-14-W

R/W WIDTH

100' RT. & LT. SURVEY ℄ FROM STA. 404+59.55 TO 436+00
40' " " " " " " " 436+00 TO 14+60.75
100' " " " " " " " 14+60.75 TO 39+09.43
Exception:- R/W Lt. of ℄ = 40' From Sta. 15+35.75 to Sta. 16+00.00

State Road 10

STATE OF FLORIDA
STATE ROAD DEPARTMENT

RIGHT OF WAY MAP

JOB NO. 5201-203, ROAD (1) HOLMES COUNTY

	Names	Dates	Approved by
Designed			Bridge Engineer
Drawn			State Highway Engineer
Traced	W. P.	8-27-46	
Checked			Drawing / Index No.
Revised	R.J.H. / C.W.R.	12-20-48 / 2-9-51	

5-21-51
3-14-52
10-8-52
2-10-52
5-26-52