P.I. STA. 251+66.00
Δ = 11°40'44" LT.
D = 1°00'00"
T = 585.98'
L = 1167.90'
R = 5729.65'
P.C. STA. 245+80.02
P.T. STA. 257+47.93

T.6.N. R.11.W

TABLE OF OWNERSHIPS

PARCEL No.	SHEET No.	NAME	AREA TAKEN	REMAINDERS RIGHT	REMAINDERS LEFT	COMMENTS	RECORDING DATA
700	1	David Dickens	0.761 Ac.	51.764 Ac.	4.553 Ac.	Temp. Const. Ease.	EXECUTED 1-23-92
~~701~~	~~1~~	~~TRUSTEES OF INTERNAL IMPROVEMENT TRUST FUND~~	~~2600 S.F.~~	—	—	~~Temp. Const. Easement~~	— VOID —
~~800~~	~~1~~	~~TRUSTEES OF INTERNAL IMPROVEMENT TRUST FUND~~	~~6090 S.F.~~	—	—	~~" " "~~	— VOID —
702	1	TRUSTEES OF INTERNAL IMPROVEMENT TRUST FUND	2600 S.F.	—	—	Temp. Const. Easement	O.R. Book 507 Page 597
801	1	TRUSTEES OF INTERNAL IMPROVEMENT TRUST FUND	6090 S.F.	—	—	Easement	O.R. Book 507 Page 596

F.A. PROJECT NO. N/A | SHEET NO.

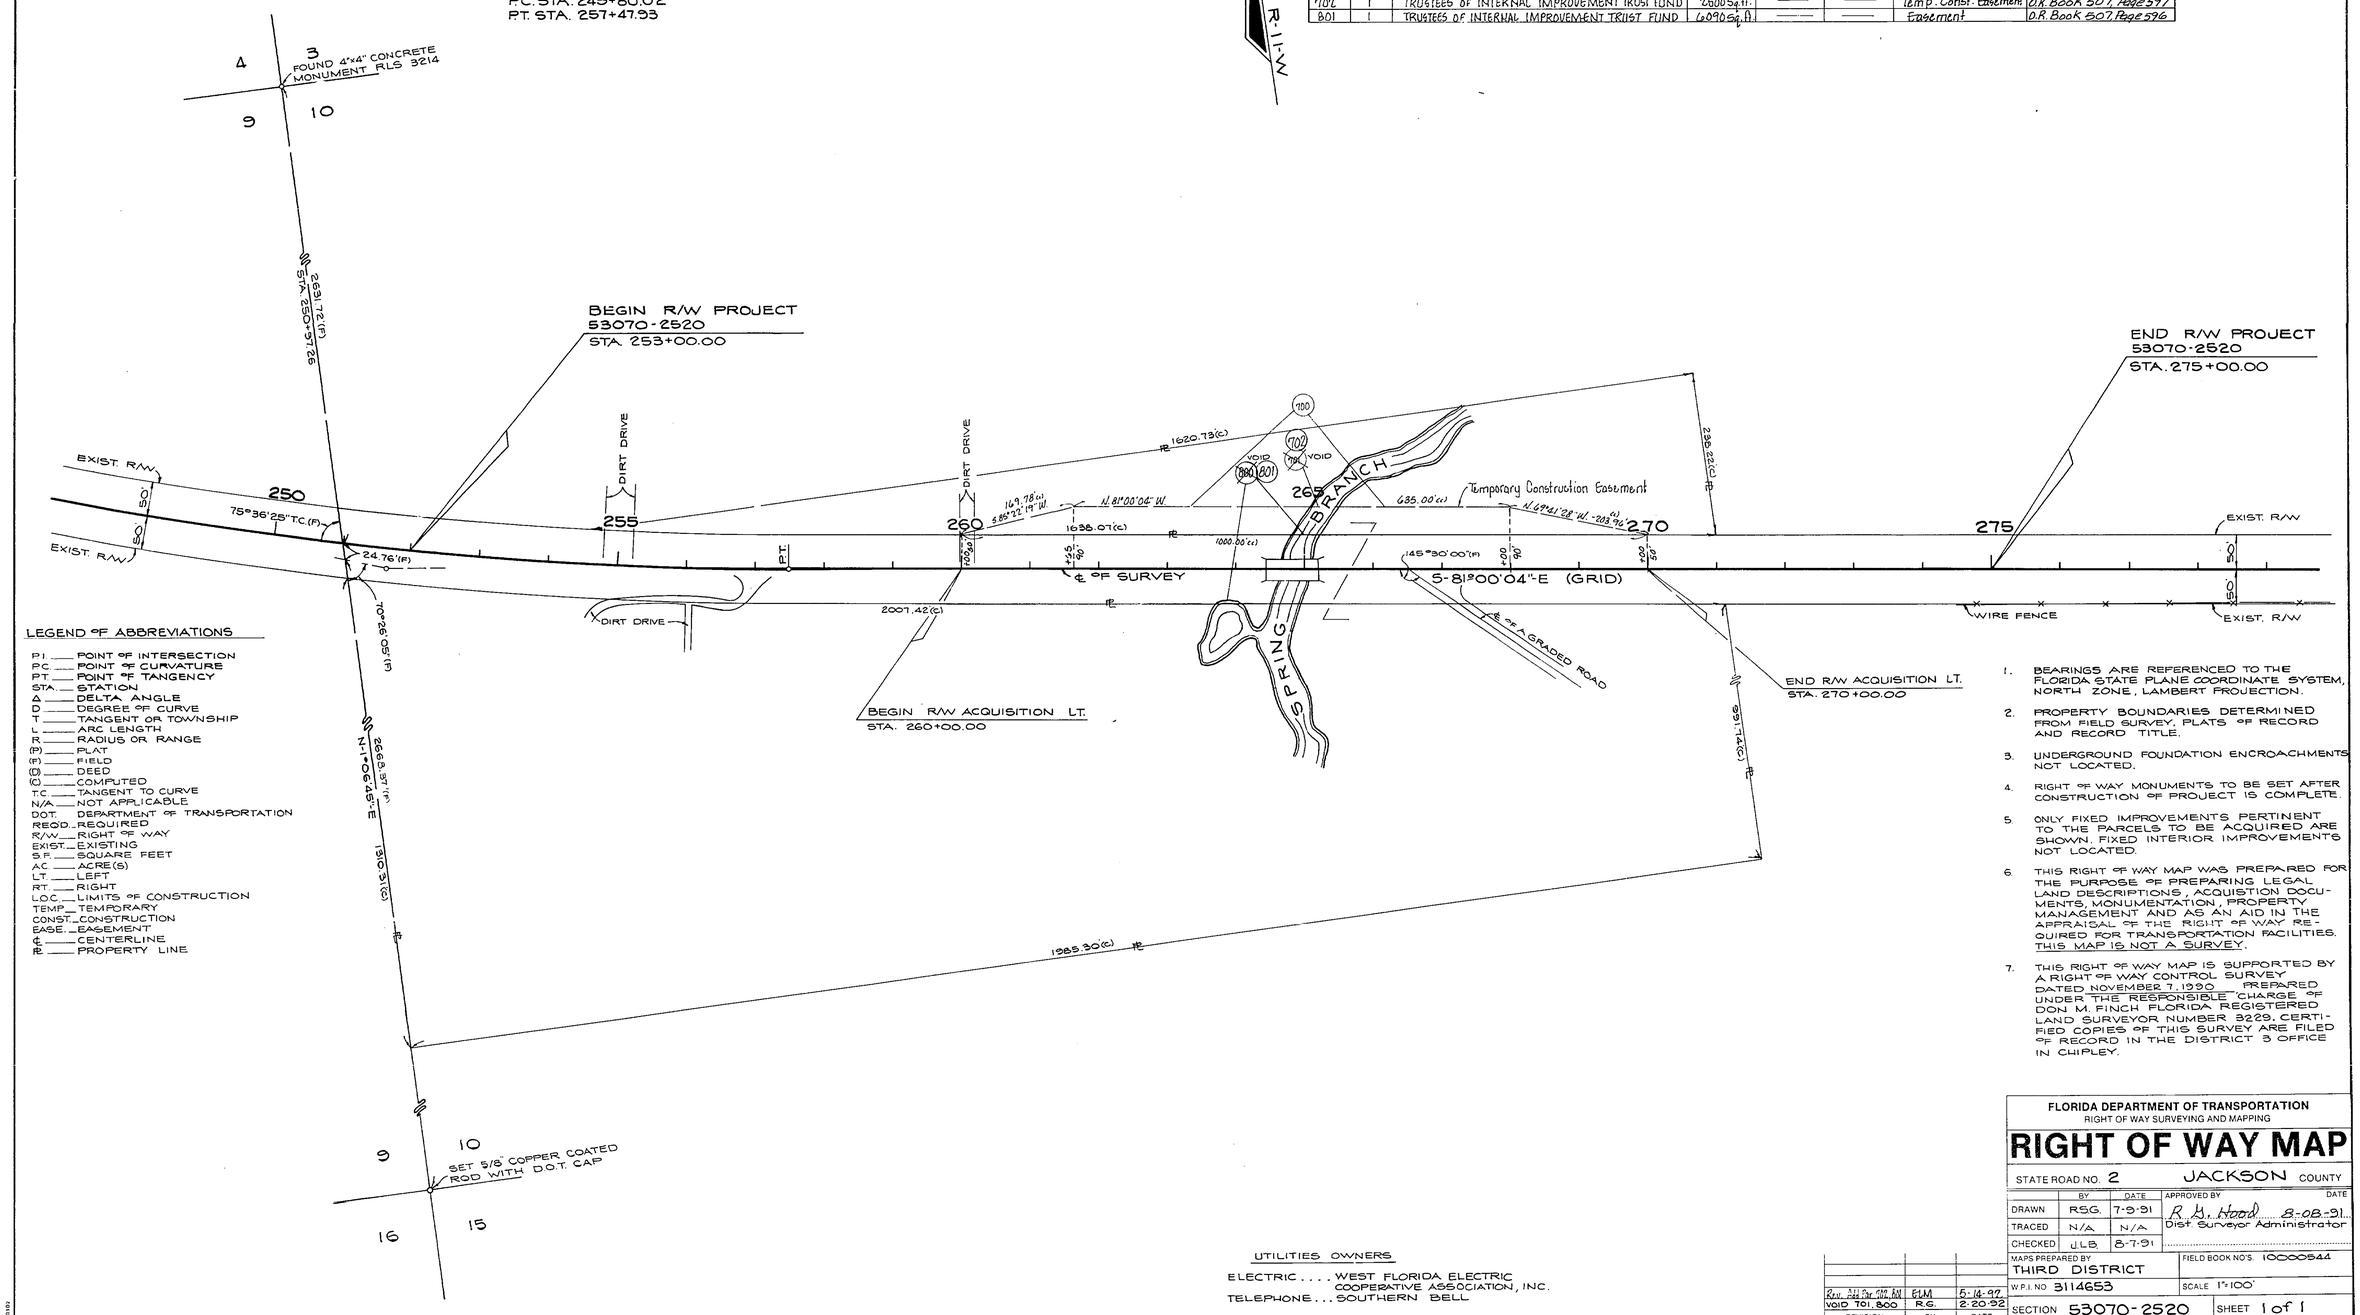

LEGEND OF ABBREVIATIONS

P.I. — POINT OF INTERSECTION
P.C. — POINT OF CURVATURE
P.T. — POINT OF TANGENCY
STA. — STATION
Δ — DELTA ANGLE
D — DEGREE OF CURVE
T — TANGENT OR TOWNSHIP
L — ARC LENGTH
R — RADIUS OR RANGE
(P) — PLAT
(F) — FIELD
(D) — DEED
(C) — COMPUTED
T.C. — TANGENT TO CURVE
N/A — NOT APPLICABLE
DOT — DEPARTMENT OF TRANSPORTATION
REQD. — REQUIRED
R/W — RIGHT OF WAY
EXIST. — EXISTING
S.F. — SQUARE FEET
AC. — ACRE(S)
LT. — LEFT
RT. — RIGHT
L.O.C. — LIMITS OF CONSTRUCTION
TEMP. — TEMPORARY
CONST. — CONSTRUCTION
EASE. — EASEMENT
℄ — CENTERLINE
℞ — PROPERTY LINE

1. BEARINGS ARE REFERENCED TO THE FLORIDA STATE PLANE COORDINATE SYSTEM, NORTH ZONE, LAMBERT PROJECTION.
2. PROPERTY BOUNDARIES DETERMINED FROM FIELD SURVEY, PLATS OF RECORD AND RECORD TITLE.
3. UNDERGROUND FOUNDATION ENCROACHMENTS NOT LOCATED.
4. RIGHT OF WAY MONUMENTS TO BE SET AFTER CONSTRUCTION OF PROJECT IS COMPLETE.
5. ONLY FIXED IMPROVEMENTS PERTINENT TO THE PARCELS TO BE ACQUIRED ARE SHOWN. FIXED INTERIOR IMPROVEMENTS NOT LOCATED.
6. THIS RIGHT OF WAY MAP WAS PREPARED FOR THE PURPOSE OF PREPARING LEGAL LAND DESCRIPTIONS, ACQUISTION DOCUMENTS, MONUMENTATION, PROPERTY MANAGEMENT AND AS AN AID IN THE APPRAISAL OF THE RIGHT OF WAY REQUIRED FOR TRANSPORTATION FACILITIES. THIS MAP IS NOT A SURVEY.
7. THIS RIGHT OF WAY MAP IS SUPPORTED BY A RIGHT OF WAY CONTROL SURVEY DATED NOVEMBER 7, 1990 PREPARED UNDER THE RESPONSIBLE CHARGE OF DON M. FINCH FLORIDA REGISTERED LAND SURVEYOR NUMBER 3229. CERTIFIED COPIES OF THIS SURVEY ARE FILED OF RECORD IN THE DISTRICT 3 OFFICE IN CHIPLEY.

UTILITIES OWNERS

ELECTRIC . . . . WEST FLORIDA ELECTRIC COOPERATIVE ASSOCIATION, INC.
TELEPHONE . . . SOUTHERN BELL

REVISION	BY	DATE
Rev. Title for ROW Mt.	ELM	5-14-92
VOID 701, 800	R.G.	2-20-92

FLORIDA DEPARTMENT OF TRANSPORTATION
RIGHT OF WAY SURVEYING AND MAPPING

RIGHT OF WAY MAP

STATE ROAD NO. 2 JACKSON COUNTY

	BY	DATE	APPROVED BY	DATE
DRAWN	RSG.	7-9-91	R. B. Hood	8-08-91
TRACED	N/A	N/A	Dist. Surveyor Administrator	
CHECKED	JLB.	8-7-91		

MAPS PREPARED BY THIRD DISTRICT
FIELD BOOK NO'S. 10000544
W.P.I. NO. 3114653
SCALE 1"=100'
SECTION 53070-2520
SHEET 1 of 1

SR 2 BRIDGE OVER SPRING BRANCH (BRIDGE No. 530047)

53070 2520