F.A. PROJECT NO.	SHEET NO.
N/A	

TABLE OF OWNERSHIPS

PARCEL NO.	SHEET NO.	NAME	AREA TAKEN	REMAINDERS RIGHT	REMAINDERS LEFT	COMMENTS	RECORDING DATA
700	1	CLAUDE MEDLOCK, et ux	153 S.F.	11984 S.F.	0	DETOUR EASE.	O.T. 7-30-93
701	1	MARGARET M. PUGH, et al	2015 S.F.	11985 S.F.	0	DETOUR EASE.	O.T. 12-8-93
~~702~~	~~1~~	~~CSX TRANSPORTATION, INC.~~	~~2471 S.F.~~			VOID	
703	1	CITY OF GRAND RIDGE	6927 S.F.	-	-	TEMP.CONST.EASE.	O.T. 7-1-93

LEGEND

(C)	-COMPUTED	P.C.	-POINT OF CURVATURE
℄	-CENTERLINE	P.I.	-POINT OF INTERSECTION
C.M.	-CONCRETE MONUMENT	⅊	-PROPERTY LINE
EXIST.	-EXISTING	T.C.E.	-TEMPORARY CONSTRUCTION EASEMENT
D	-DEGREE	P.T.	-POINT OF TANGENCY
(D)	-DEED	R.	-RADIUS/RANGE
(F)	-FIELD	R.R.	-RAILROAD
F.A.	-FEDERAL AID	W.P.I.	-WORK PROJECT ITEM
I.P.	-IRON PIPE	R/W	-RIGHT OF WAY
I.R.	-IRON ROD	SEC.	-SECTION
L	-LENGTH	STA.	-STATION
et ux	-AND WIFE	N/A	-NOT APPLICABLE
et al	-AND OTHERS	T.	-TANGENT/TOWNSHIP
(P)	-PLAT	S.F.	-SQUARE FEET
D.B.	-DEED BOOK	ST.	-STREET
EASE.	-EASEMENT	PRELIM.	-PRELIMINARY
FND.	-FOUND	NO.	-NUMBER
INC.	-INCORPORATED	S.R.	-STATE ROAD
°	-DEGREES	AVE.	-AVENUE
′	-MINUTES/FEET	PROJ.	-PROJECT
″	-SECONDS/INCHES	N	-NORTH
TEMP.	-TEMPORARY	S	-SOUTH
CONST.	-CONSTRUCTION	E	-EAST
LT.	-LEFT	W	-WEST
RT.	-RIGHT		

SEC. 27, T-4-N., R-8-W.

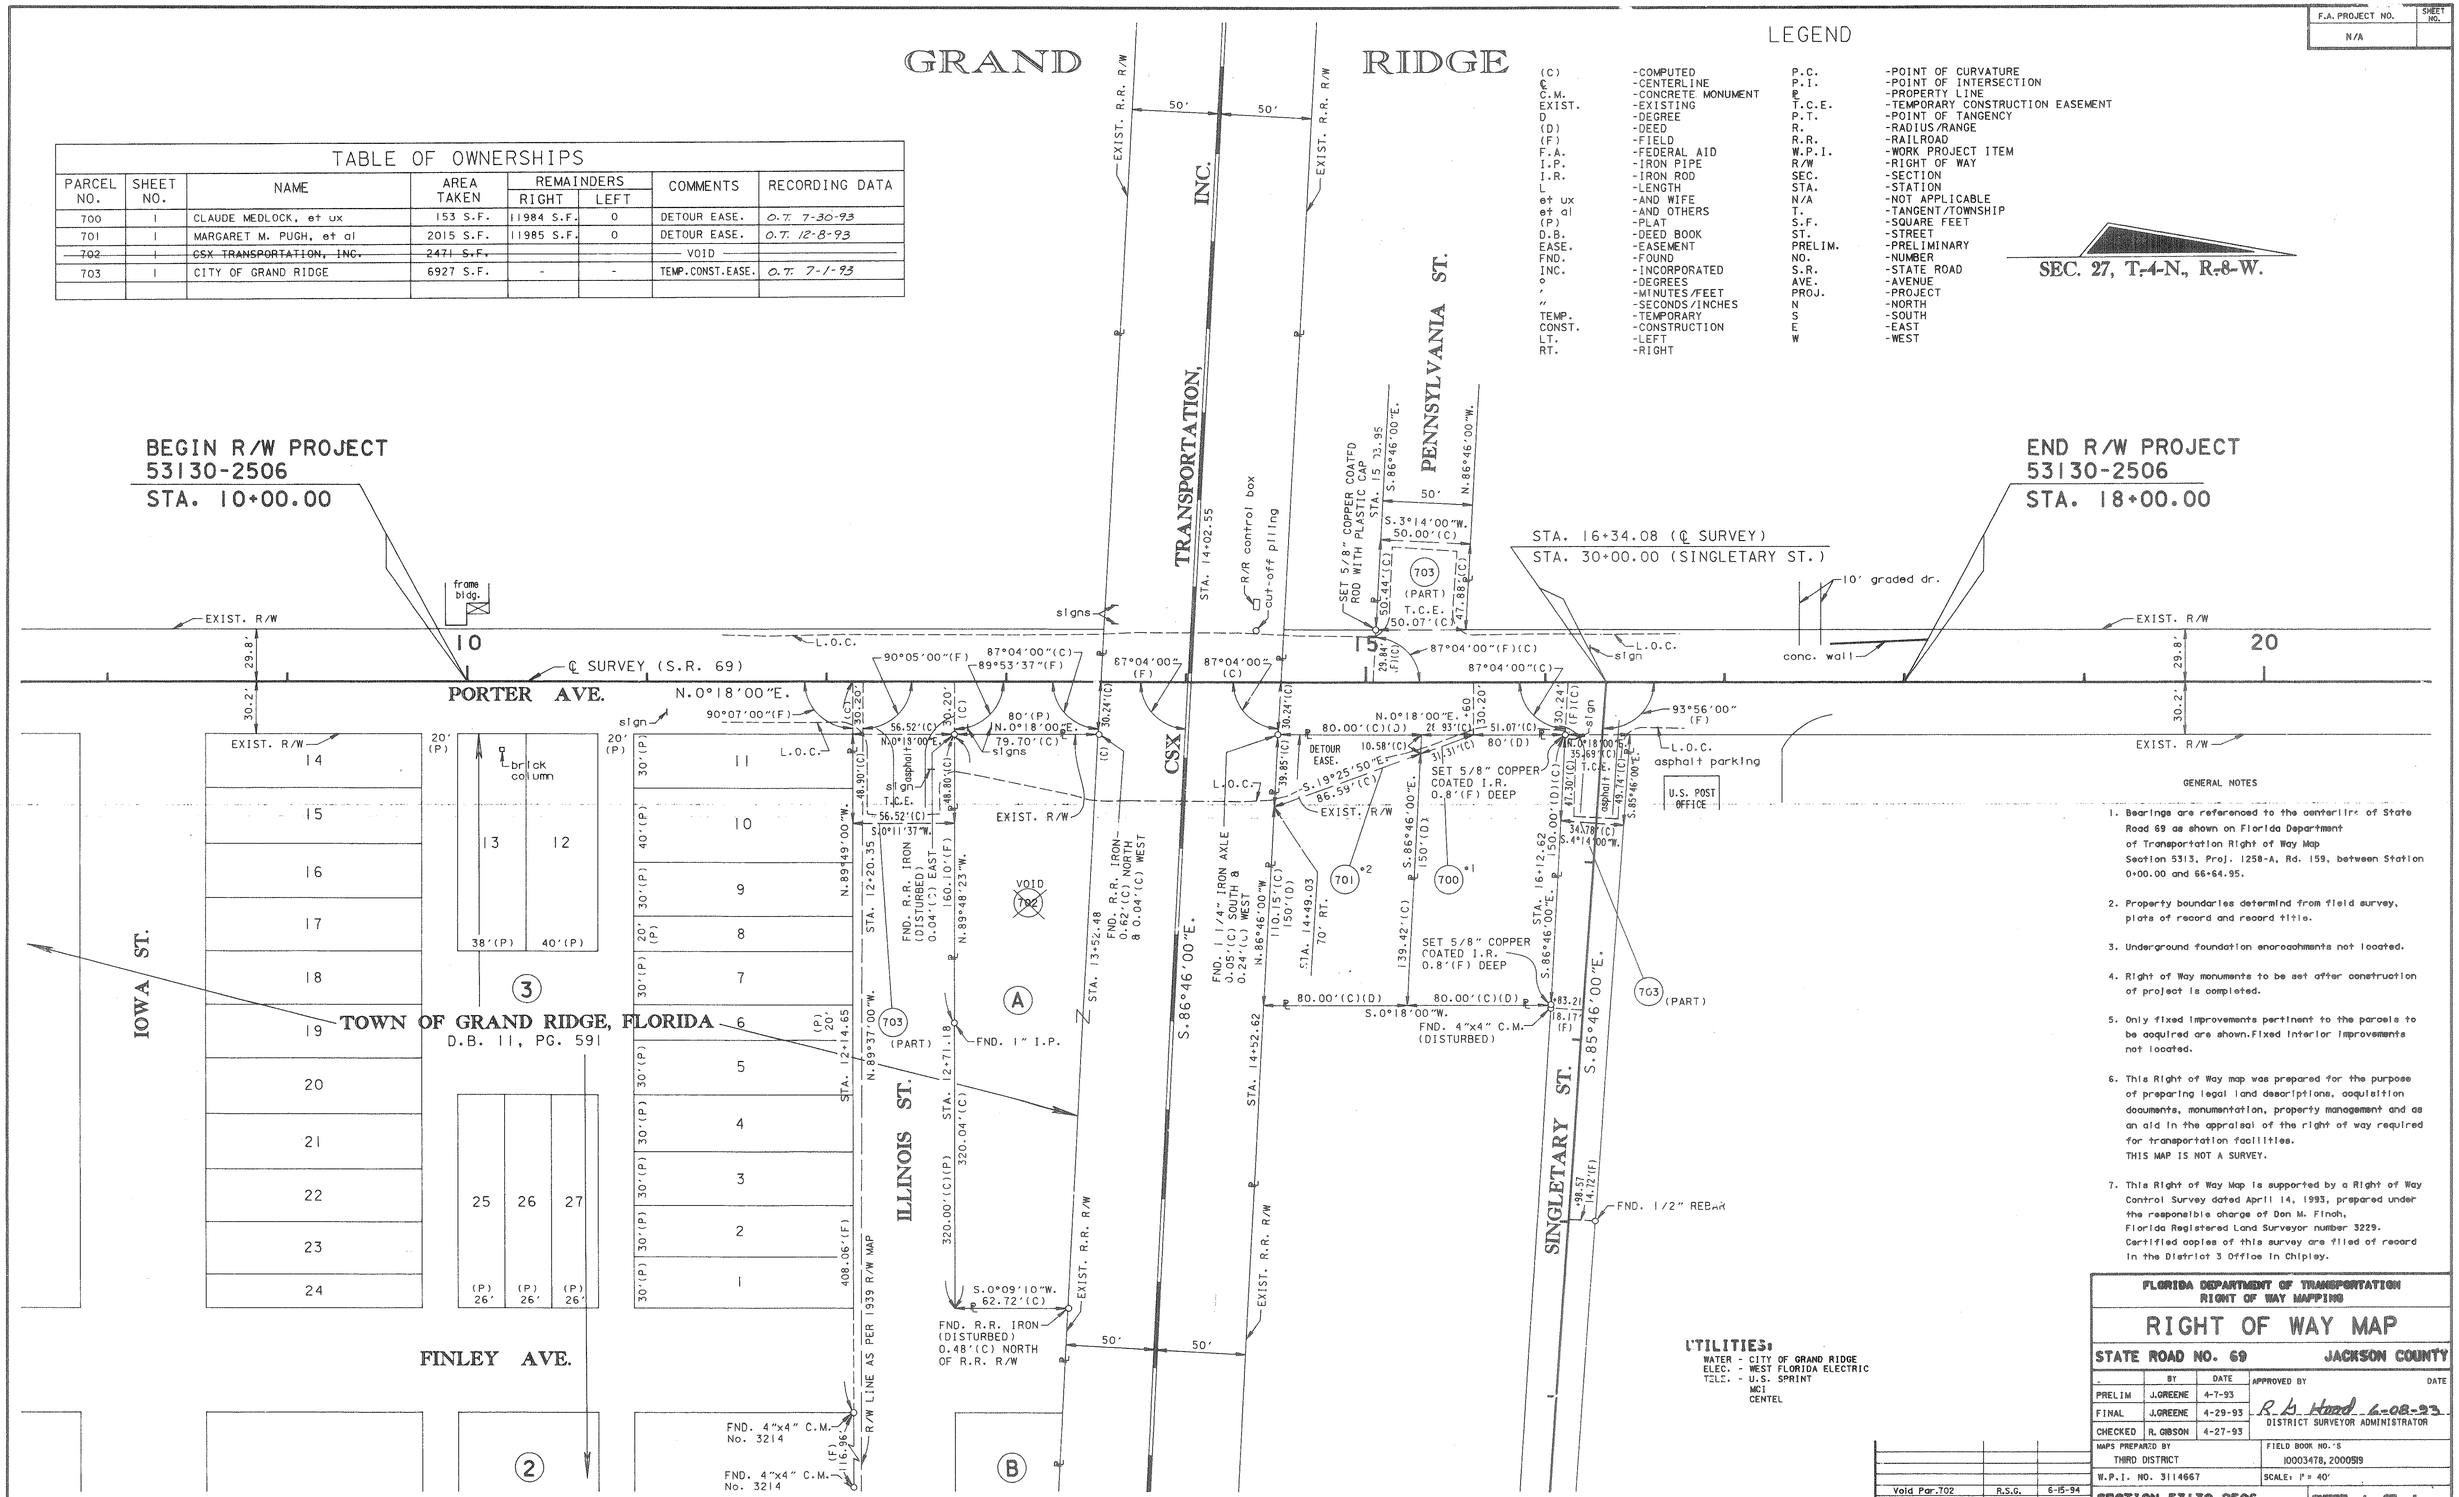

GENERAL NOTES

1. Bearings are referenced to the centerline of State Road 69 as shown on Florida Department of Transportation Right of Way Map Section 5313, Proj. 1258-A, Rd. 159, between Station 0+00.00 and 66+64.95.
2. Property boundaries determind from field survey, plats of record and record title.
3. Underground foundation encroachments not located.
4. Right of Way monuments to be set after construction of project is completed.
5. Only fixed improvements pertinent to the parcels to be acquired are shown. Fixed interior improvements not located.
6. This Right of Way map was prepared for the purpose of preparing legal land descriptions, acquisition documents, monumentation, property management and as an aid in the appraisal of the right of way required for transportation facilities. THIS MAP IS NOT A SURVEY.
7. This Right of Way Map is supported by a Right of Way Control Survey dated April 14, 1993, prepared under the responsible charge of Don M. Finch, Florida Registered Land Surveyor number 3229. Certified copies of this survey are filed of record in the District 3 Office in Chipley.

UTILITIES:
WATER - CITY OF GRAND RIDGE
ELEC. - WEST FLORIDA ELECTRIC
TELE. - U.S. SPRINT
MCI
CENTEL

REVISION	BY	DATE
Void Par.702	R.S.G.	6-15-94

FLORIDA DEPARTMENT OF TRANSPORTATION
RIGHT OF WAY MAPPING

RIGHT OF WAY MAP

STATE ROAD NO. 69 — **JACKSON COUNTY**

	BY	DATE	APPROVED BY	DATE
PRELIM	J.GREENE	4-7-93	R. A. Hood	6-08-93
FINAL	J.GREENE	4-29-93	DISTRICT SURVEYOR ADMINISTRATOR	
CHECKED	R. GIBSON	4-27-93		

MAPS PREPARED BY: THIRD DISTRICT
FIELD BOOK NO.'S: 10003478, 2000519
W.P.I. NO. 3114667
SCALE: 1" = 40'

SECTION 53130-2506 — SHEET 1 OF 4

S.R. 69 AT CSX RAILROAD CROSSING No. 340015C IN GRAND RIDGE