FED. ROAD DIV. No.	STATE	PROJECT No.	FISCAL YEAR	SHEET No.
3	FLA	54060 (707)		2

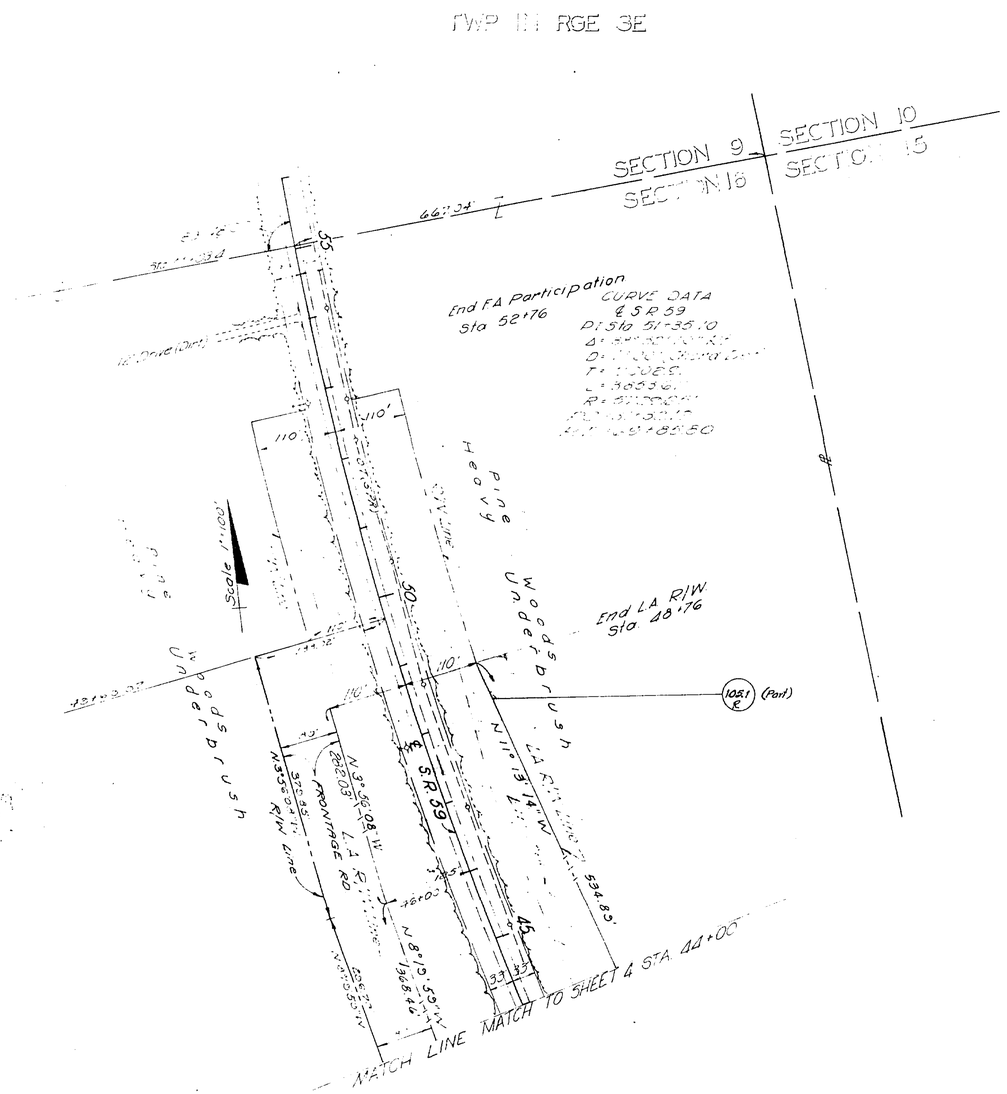

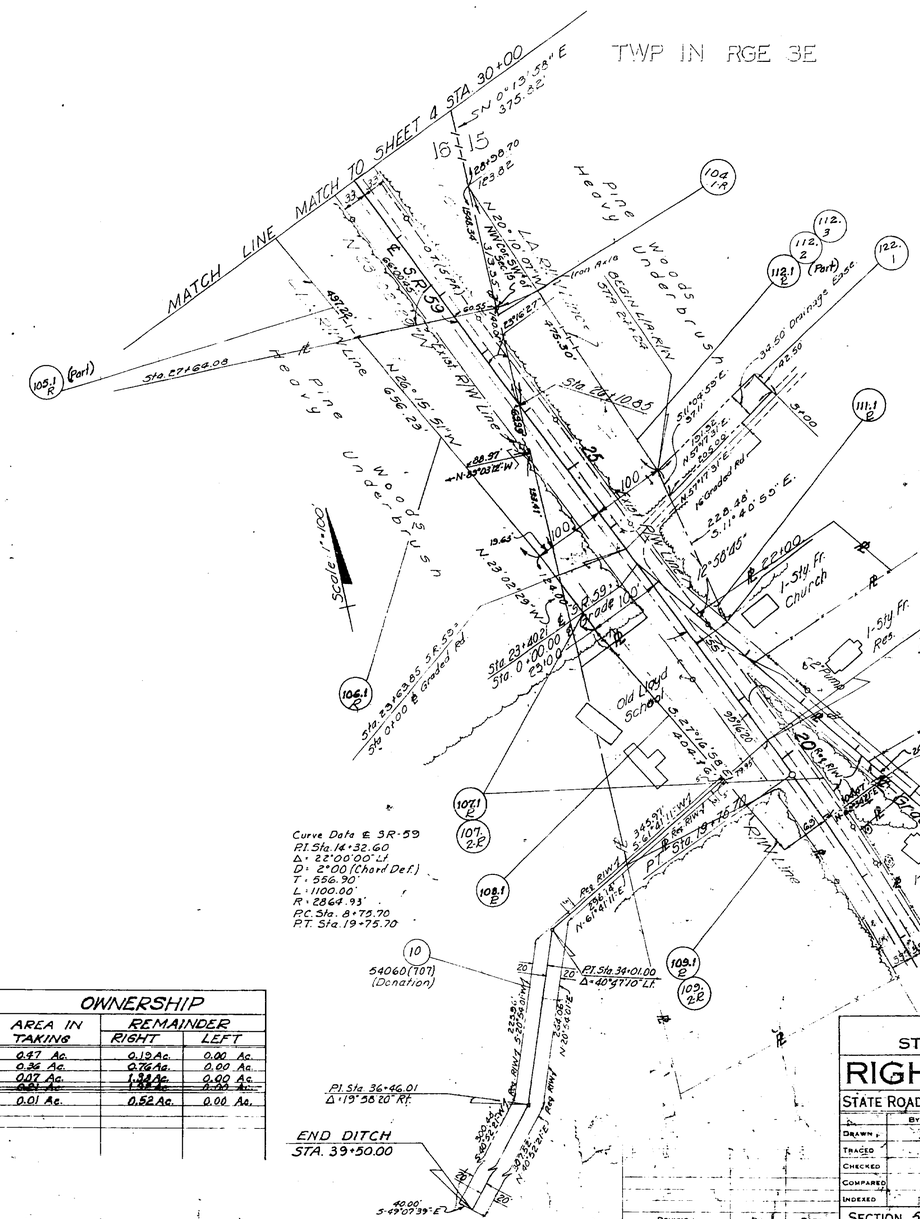

TABLE OF OWNERSHIP				
NUMBER	NAME	AREA IN TAKING	REMAINDER RIGHT	REMAINDER LEFT
107.1-R	Colored Assoc. Society	0.47 Ac.	0.19 Ac.	0.00 Ac.
108.1-R	B.P.I. of Jefferson County	0.36 Ac.	0.76 Ac.	0.00 Ac.
109.1-R	Annie Lee Keaton	0.07 Ac.	1.38 Ac.	0.00 Ac.
~~110.1~~	~~Alex Jones~~	~~0.01 Ac.~~	~~1.52 Ac.~~	~~0.00 Ac.~~
111.1-R	Mt. Zion Baptist Church	0.01 Ac.	0.52 Ac.	0.00 Ac.

STATE OF FLORIDA
STATE ROAD DEPARTMENT

RIGHT OF WAY MAP

STATE ROAD NO. 59 JEFFERSON COUNTY

	BY	DATE	APPROVED BY	DATE
DRAWN			E.W. Lee	
TRACED				DISTRICT ENGINEER
CHECKED			H. E. Nadel	4-28-75
COMPARED				ENGINEER OF RIGHTS OF WAY
INDEXED				STATE HIGHWAY ENGINEER

REVISION | BY | DATE

SECTION 54060 SHEET 2 OF 2

OLD PROJ. (707)