FED. ROAD DIV. No.	STATE	F A PROJECT NO.	FISCAL YEAR	SHEET No.
3	FLA.			1

Book No.'s 10157395
10157397

TABLE OF OWNERSHIP

PARCEL No.	NAME	AREA TAKEN	REMAINDERS LEFT	REMAINDERS RIGHT	COMMENTS
~~700.1~~	~~Irene Elizabeth Sedgwick~~ ~~VOID~~	~~0.86 Ac.~~			~~Temp. Detour Ease~~
~~701.1~~	~~Edward H. Berry, etux~~ ~~VOID~~	~~0.46 Ac.~~			~~Temp. Detour Ease~~
702.1	Conifer Farms Inc.	0.72 Ac.			Temp. Detour Ease.
703.1	Olive Baptist Church	0.25 Ac.			Temp. Detour Ease.

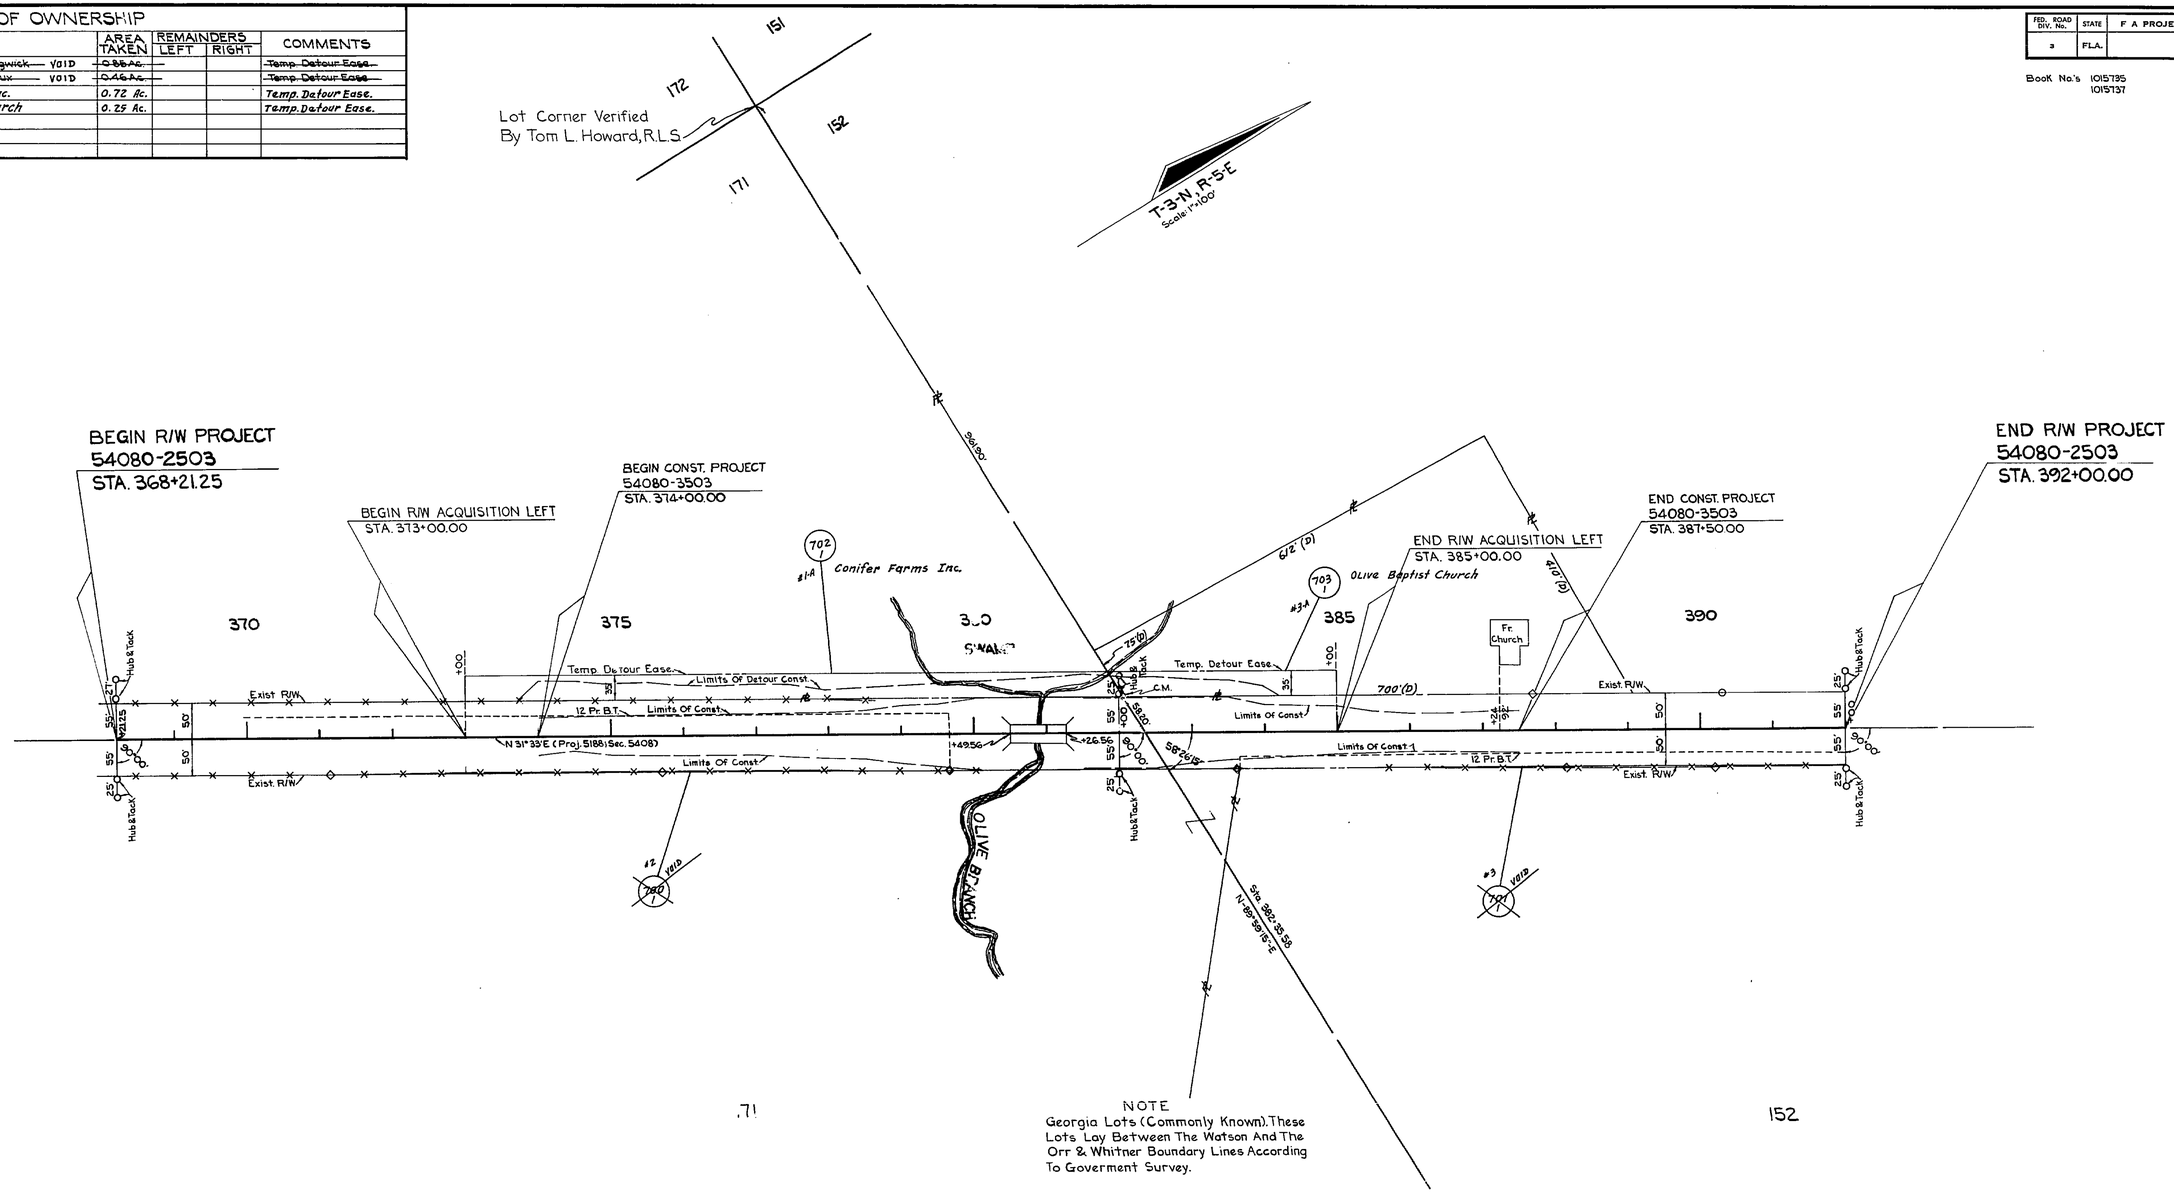

NOTE
Georgia Lots (Commonly Known). These Lots Lay Between The Watson And The Orr & Whitner Boundary Lines According To Goverment Survey.

UTILITY OWNERS
TELEPHONE: Central Telephone Co.
POWER: Tri-County Electric Co.

B.I. No. 315208

STATE OF FLORIDA
DEPARTMENT OF TRANSPORTATION

RIGHT OF WAY MAP

STATE ROAD No. 149 JEFFERSON COUNTY

	BY	DATE	APPROVED BY	DATE
DRAWN			[signature]	12-1-77 DISTRICT ENGINEER
TRACED	P. Cook	9-9-77		
CHECKED	F.A.	9-13-77	[signature]	12-12-77 ENGINEER OF RIGHT OF WAY
COMPARED				
INDEXED				STATE HIGHWAY ENGINEER

REVISION	BY	DATE

SECTION 54080-2503 SHEET 1 OF 1

OLIVE BRANCH BRIDGE NO. 540030