FED. ROAD DIV. No.	STATE	PROJECT No.	FISCAL YEAR	SHEET No.
3	FLA.	56602-2601		1

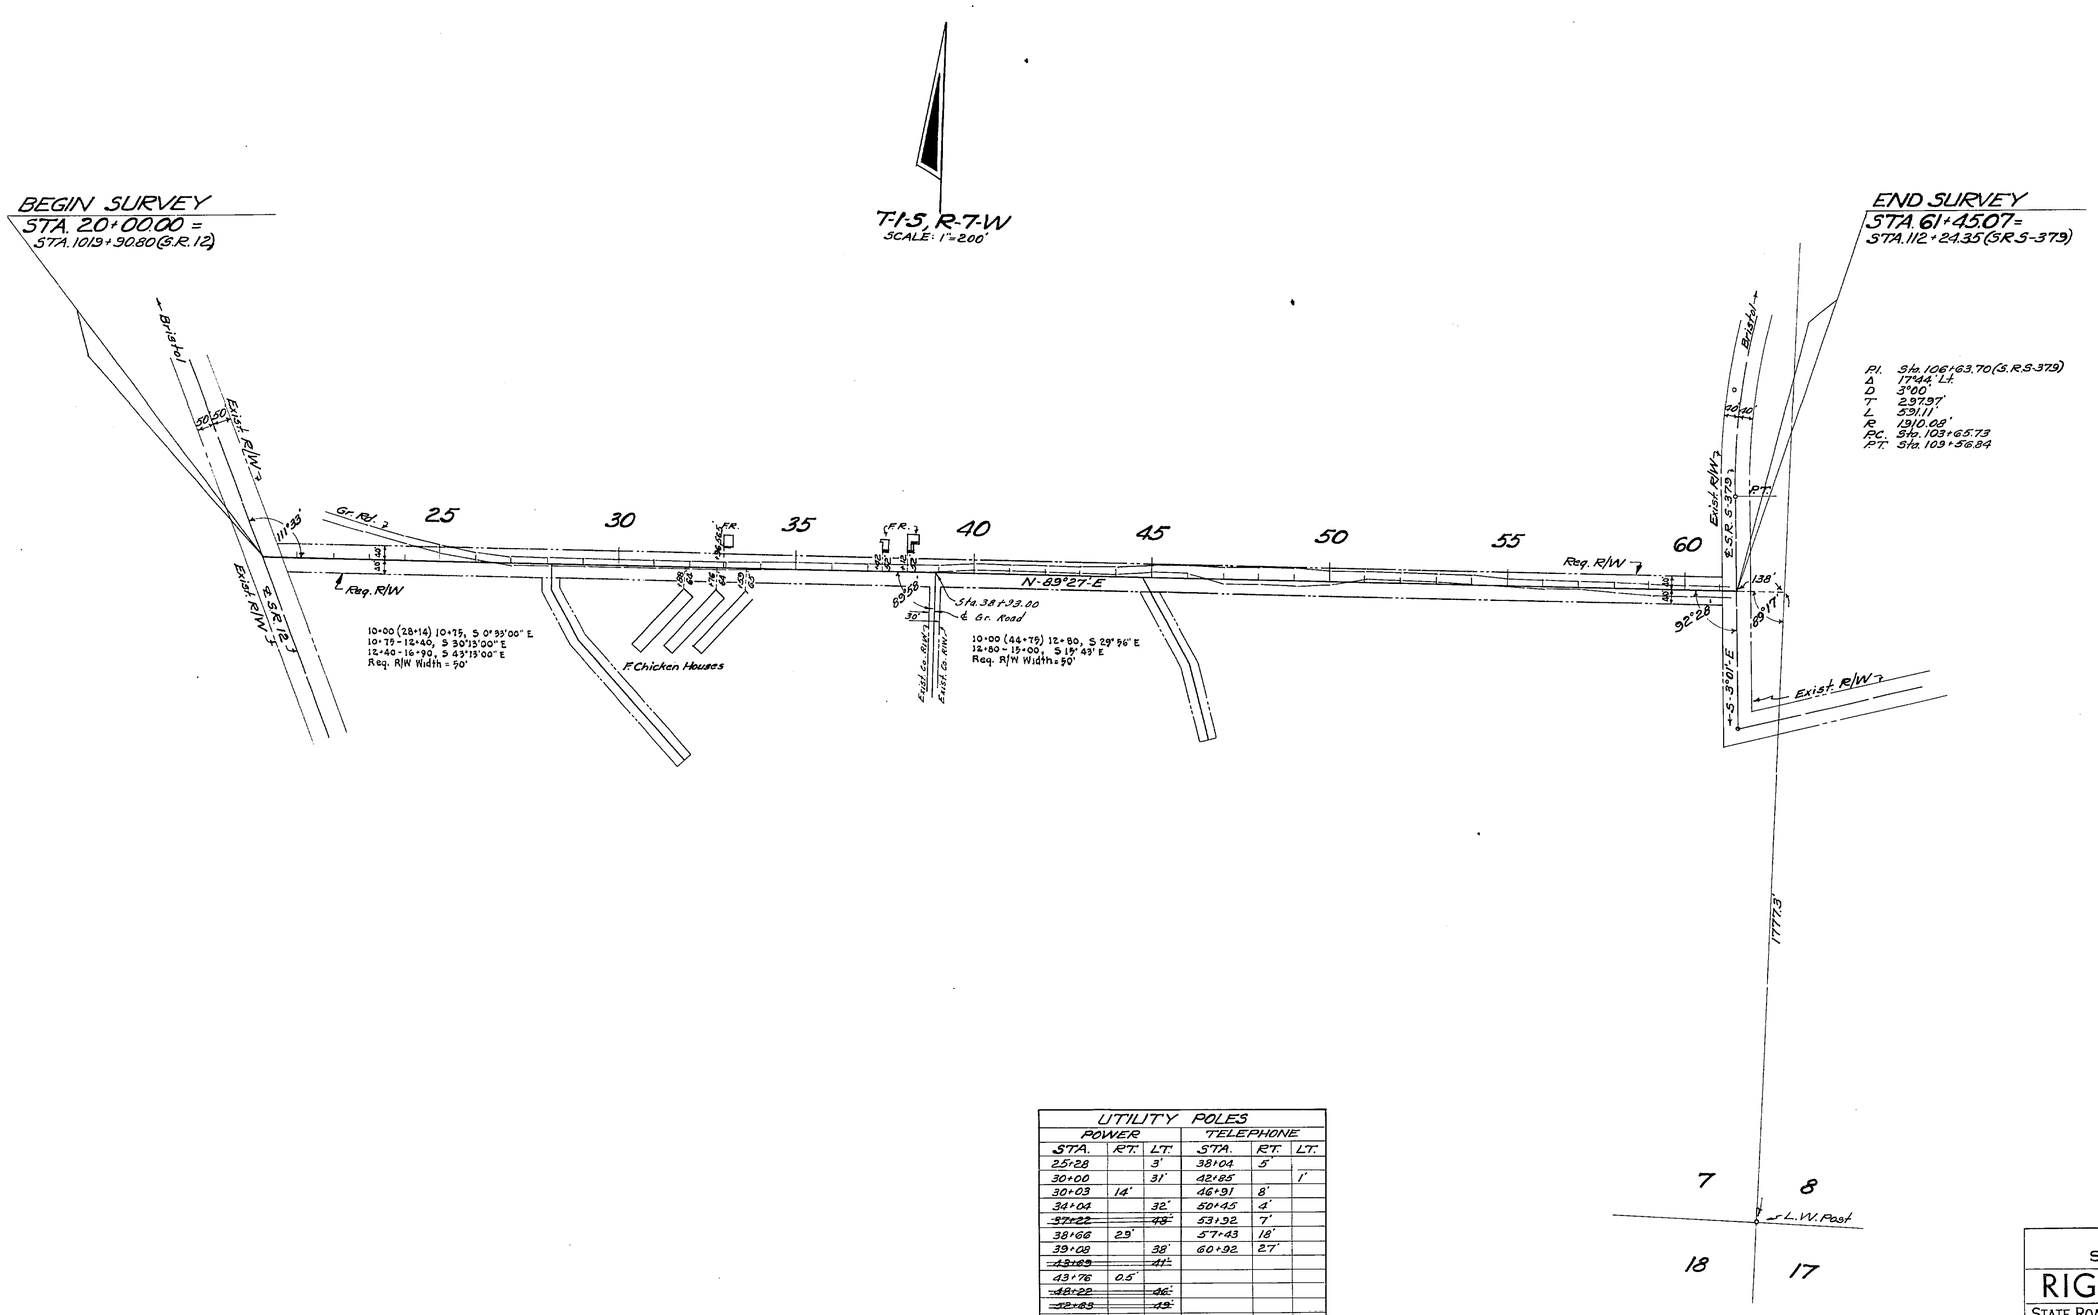

UTILITY POLES					
POWER			TELEPHONE		
STA.	RT.	LT.	STA.	RT.	LT.
25+28		3'	38+04	5'	
30+00		31'	42+85		1'
30+03	14'		46+91	8'	
34+04		32'	50+45	4'	
~~37+22~~		~~48'~~	53+92	7'	
38+68	29'		57+43	18'	
39+08		38'	60+92	27'	
~~43+89~~		~~41'~~			
43+76	0.5'				
~~48+22~~		~~46'~~			
~~52+83~~		~~45'~~			
~~57+86~~		~~52'~~			
Owner: Talquin Elec. Coop.			Owner: St. Joseph Tele. Co.		

STATE OF FLORIDA
STATE ROAD DEPARTMENT

RIGHT OF WAY MAP

STATE ROAD No. S-379-A LIBERTY COUNTY

	BY	DATE	APPROVED BY	DATE
DRAWN				
TRACED	D.F.E.	6-14-65	DISTRICT ENGINEER	
CHECKED				
COMPARED			ENGINEER OF RIGHTS OF WAY	
INDEXED			STATE HIGHWAY ENGINEER	

REVISION	BY	DATE
Ditches	B.W.	8-12-69
R/W Lines	BW	8-12-69
County R/W	J.M.-T.O.W.	7-23-65

SECTION. 56602-2601 SHEET 1 OF 1

SR 12 SOUTH OF BRISTOL TO SR S-379