FED. ROAD DIV. No.	STATE	F A PROJECT NO.	FISCAL YEAR	SHEET No.
8	FLA.	HES-422-1(13)		

BK. # 1022373

TABLE OF OWNERSHIP

PARCEL Nº	NAME	AREA TAKEN	REMAINDERS RIGHT	REMAINDERS LEFT	COMMENTS
~~100.1~~	~~Okaloosa County~~	~~5414 Sq Ft~~	~~1.03 Ac~~		VOID
~~101.1~~	~~Okaloosa County~~	~~491 Sq Ft~~	~~0.72 Ac~~		VOID
~~102.1~~	~~Okaloosa County~~	~~5072 Sq Ft~~	~~1532 Sq Ft~~		VOID
~~100.1~~	~~Okaloosa County~~	~~1392~~			VOID

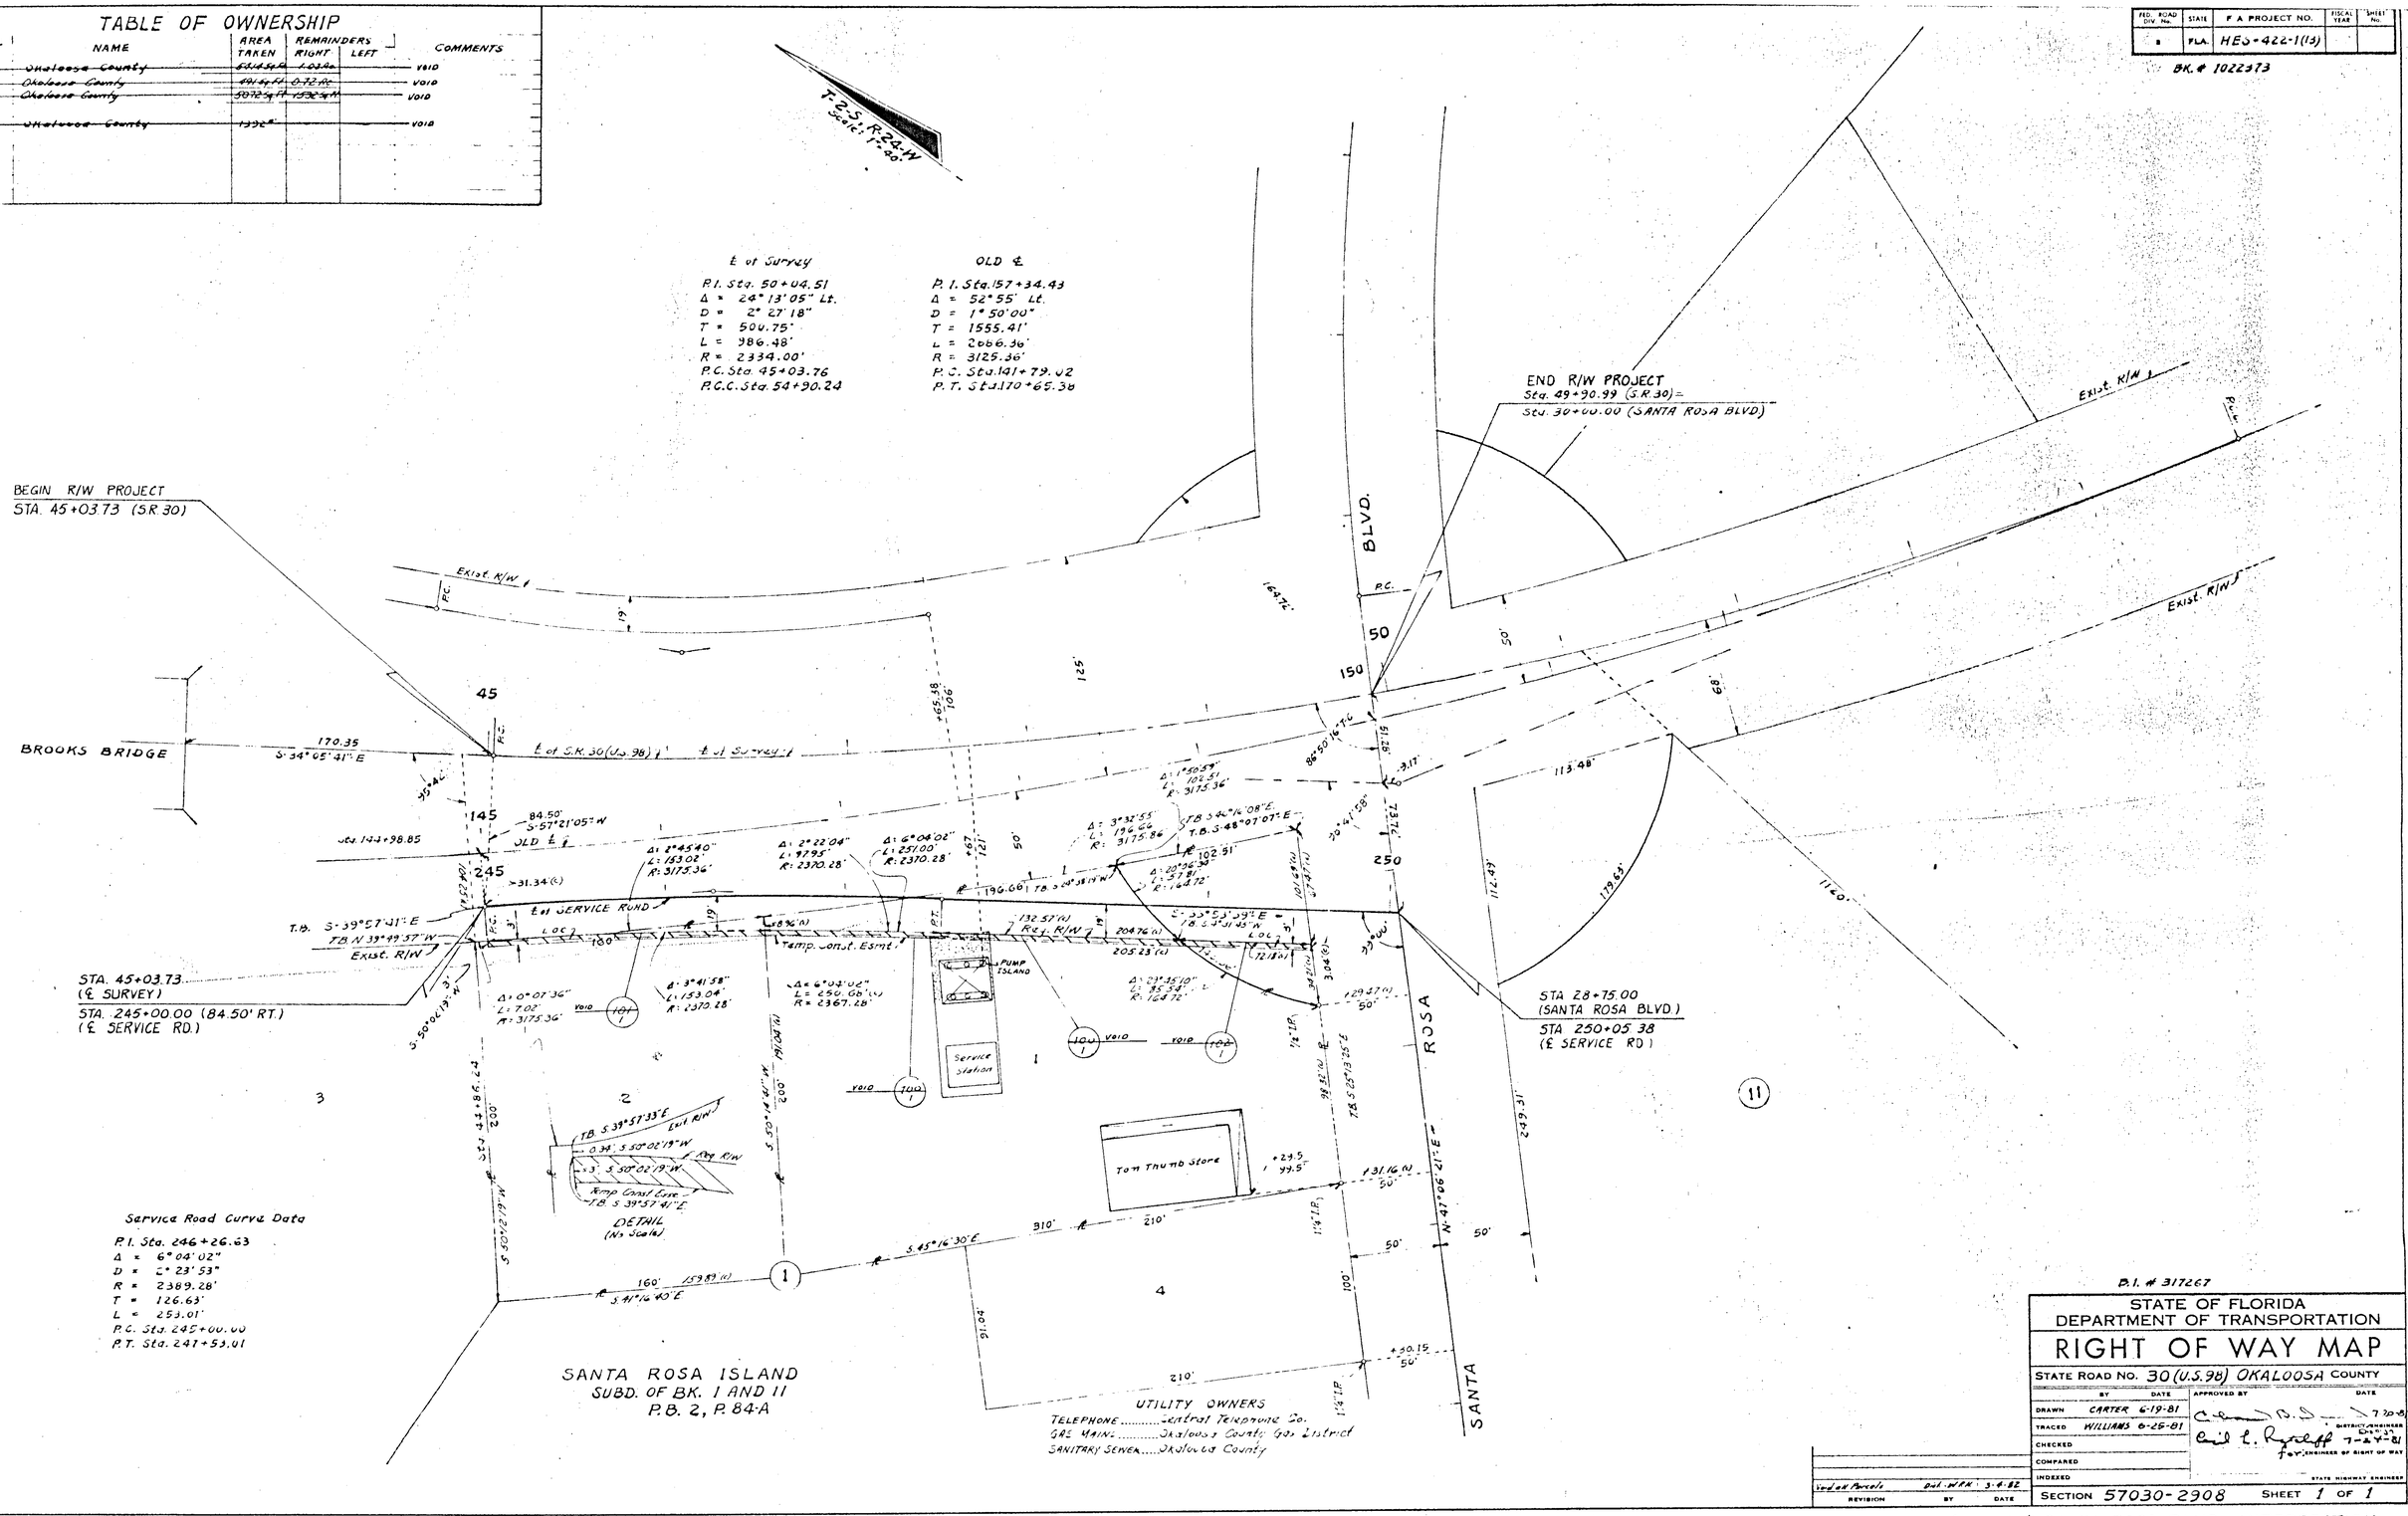

℄ of Survey
P.I. Sta. 50+04.51
Δ = 24° 13' 05" Lt.
D = 2° 27' 18"
T = 500.75'
L = 986.48'
R = 2334.00'
P.C. Sta. 45+03.76
P.C.C. Sta. 54+90.24

OLD ℄
P.I. Sta. 157+34.43
Δ = 52° 55' Lt.
D = 1° 50' 00"
T = 1555.41'
L = 2666.36'
R = 3125.36'
P.C. Sta. 141+79.02
P.T. Sta. 170+65.38

Service Road Curve Data
P.I. Sta. 246+26.63
Δ = 6° 04' 02"
D = 2° 23' 53"
R = 2389.28'
T = 126.63'
L = 253.01'
P.C. Sta. 245+00.00
P.T. Sta. 247+53.01

B.I. # 317267

STATE OF FLORIDA
DEPARTMENT OF TRANSPORTATION

RIGHT OF WAY MAP

STATE ROAD NO. 30 (U.S. 98) OKALOOSA COUNTY

	BY	DATE	APPROVED BY	DATE
DRAWN	CARTER	6-19-81	[signature]	7-20-81
TRACED	WILLIAMS	6-25-81	[signature] for ENGINEER OF RIGHT OF WAY	7-24-81
CHECKED				
COMPARED				
INDEXED				

DISTRICT ENGINEER
Design
STATE HIGHWAY ENGINEER

REVISION	BY	DATE
Void all Parcels	Dist. WRK	3-4-82

SECTION 57030-2908 SHEET 1 OF 1

