FED. ROAD DIV. No.	STATE	F A PROJECT NO.	FISCAL YEAR	SHEET No.
2	FLA.	HHS-1327-(1)		1

BOOK NUMBERS 1005419
1005420

SEC. 4, T-1-N, R-28-W
Scale: 1"=50'

M I L T O N

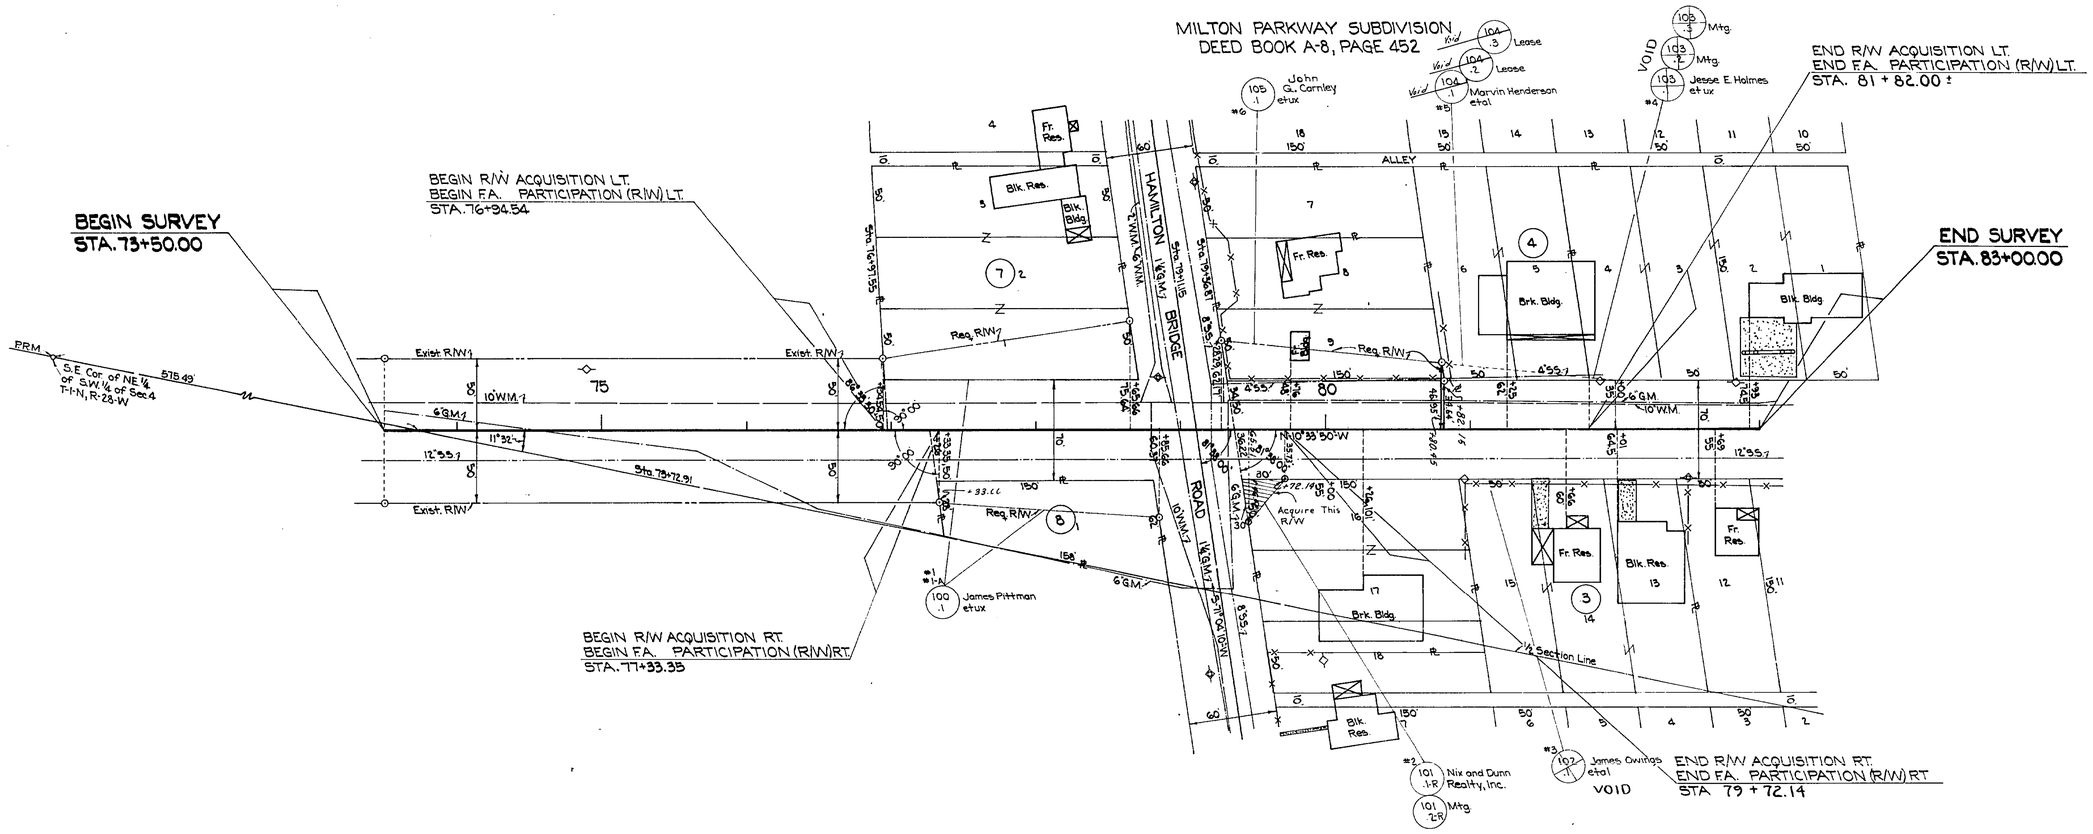

NOTE:

O----R/W Mrk.

These symbols denote the location of underground Permanent R/W Markers (P. R/W M.) The P. R/W M. are 5/8" copper coated rods. Above ground reference markers are located within 1' of the P. R/W M., where possible.

The locations of the P. R/W M. were established by field survey in February 1977. The original field notes are filed in the District 3 Office, State of Florida Department of Transportation, Chipley, Florida. Copies of these notes are filed in the office of R/W Engineering, State of Florida Department of Transportation, Tallahassee, Florida.

Filed for record in the Office of the Clerk of the Circuit Court for the County of Santa Rosa, State of Florida, in Map Book A, Page 19 on the 16th day of August A.D. 1977.

Clerk of the Circuit Court
Santa Rosa County, Florida

TABLE OF OWNERSHIP

NO.	NAME	AREA IN TAKING	REMAINDER RT.	REMAINDER LT.	REMARKS
100.1	James Pittman, et ux	7872 sq. ft.	4950 sq. ft.	2021 sq. ft.	
101.1-R	Nix and Dunn Realty	460 sq. ft.	17502 sq. ft.	0	
~~102.1~~	~~James M. Owings, et al~~	~~338 sq. ft.~~	~~22162 sq. ft.~~	~~0~~	VOID
~~103.1~~	~~Jesse E. Holmes, et al~~	~~18 sq. ft.~~	~~0~~	~~29582 sq. ft.~~	VOID
~~104.1~~	~~Marvin Henderson, et al~~	~~700 sq. ft.~~	~~0~~	~~14100 sq. ft.~~	VOID
105.1	John Q. Carnley, et ux	3000 sq. ft.	0	11850 sq. ft.	

UTILITY OWNERS
WATER: City of Milton
GAS: City of Milton
SANITARY SEWER: City of Milton
POWER: Gulf Power Company
TELEPHONE: Southern Bell Telephone Co.

REVISION	BY	DATE
As P.R.M.'s	D.H.B.	8-5-77
R/W	BW-ALL	9-2-75
R/W	J.P.	7-10-75

B.I. NUMBER 317964

STATE OF FLORIDA
DEPARTMENT OF TRANSPORTATION

RIGHT OF WAY MAP

STATE ROAD No. 89 SANTA ROSA COUNTY

	BY	DATE	APPROVED BY	DATE
DRAWN				
TRACED	I.L.C.	1-17-75	DISTRICT ENGINEER	
CHECKED	C.E.H.	1-28-75	ENGINEER OF RIGHT OF WAY	2-5-75
COMPARED				
INDEXED			STATE HIGHWAY ENGINEER	

SECTION 58001-2901 SHEET 1 OF 1

HAMILTON BRIDGE ROAD AND S.R. 89 INTERSECTION