FED. ROAD DIST. No.	STATE	FED. AID PROJ. No.	FISCAL YEAR	SHEET NO.	TOTAL SHEETS
8	FLA.	5805-13 5809-302	44	1	3

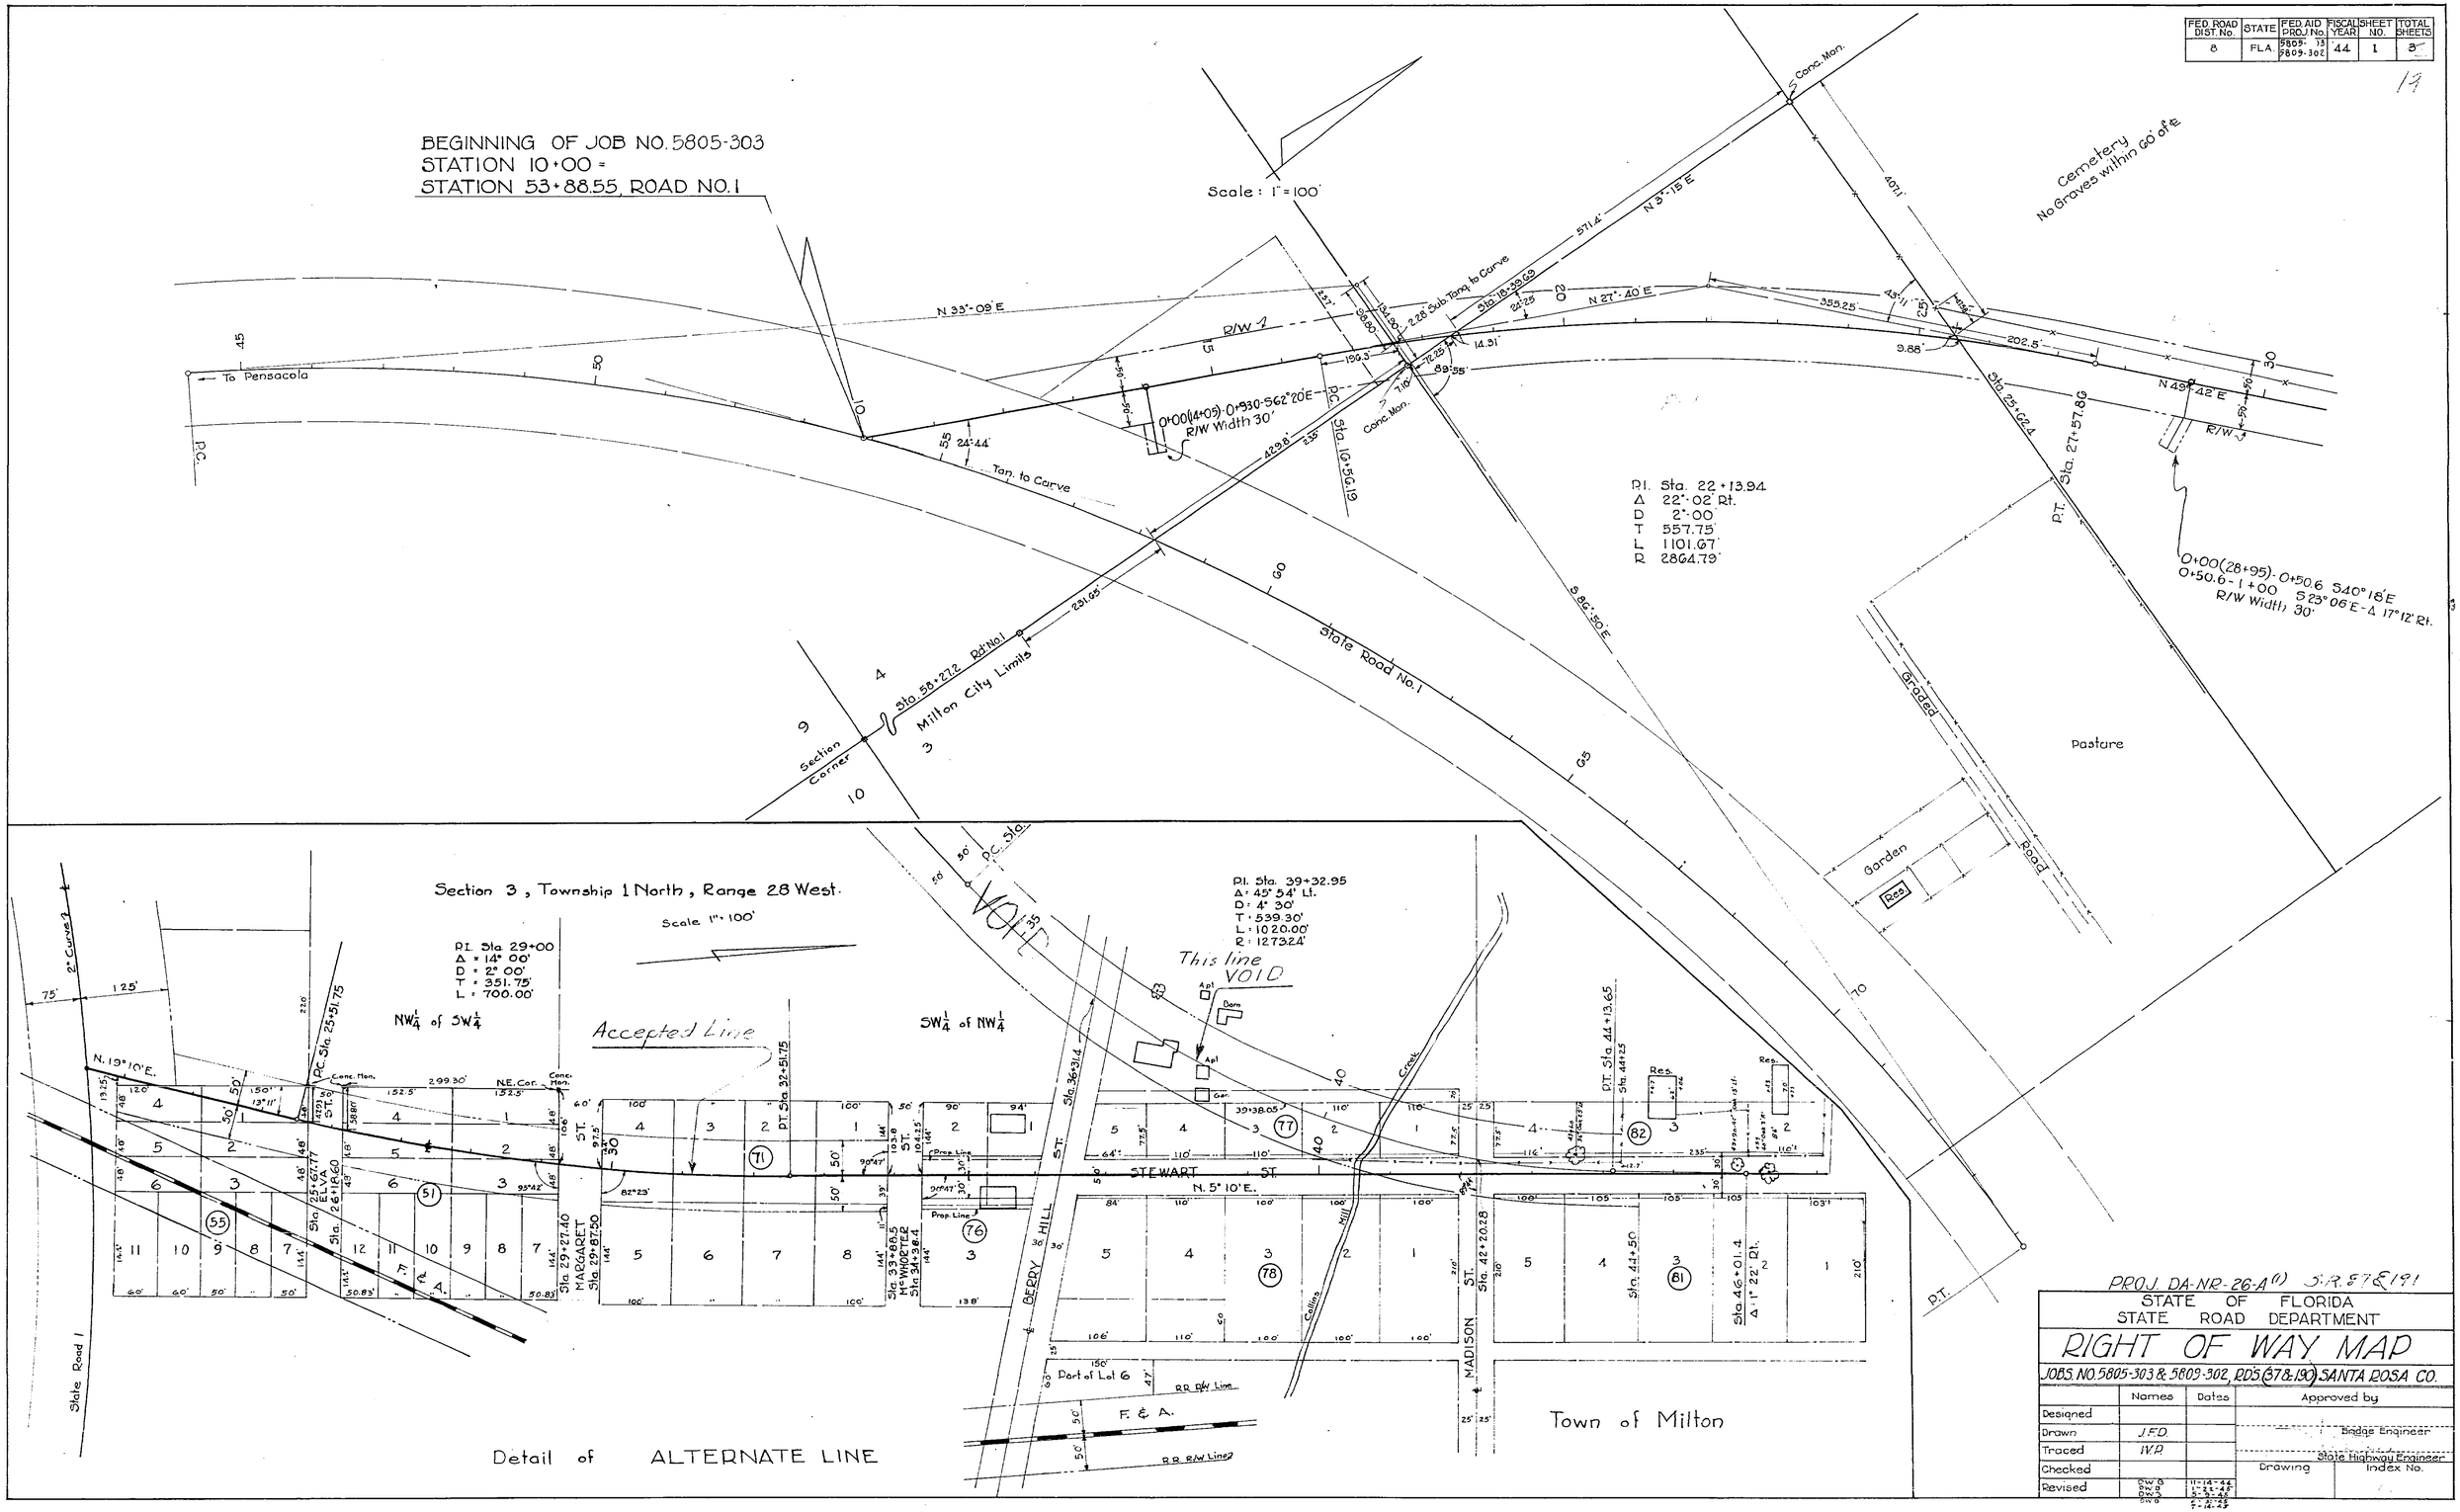

PROJ. DA-NR-26-A(1) S.R. 87 & 191

STATE OF FLORIDA
STATE ROAD DEPARTMENT

RIGHT OF WAY MAP

JOBS NO. 5805-303 & 5809-302, RDS (37 & 190) SANTA ROSA CO.

	Names	Dates	Approved by
Designed			
Drawn	J.F.D.		Bridge Engineer
Traced	W.P.		
Checked			State Highway Engineer
Revised	DWG	11-14-44	Drawing / Index No.
	DWG	1-22-45	
	DWG	5-3-45	
	DWG	6-30-45	
		7-16-45	

FED. ROAD DIST. No.	STATE	~~FED. AID PROJ. No.~~ Jobs	FISCAL YEAR	SHEET NO.	TOTAL SHEETS
8	FLA.	5809-303 5809-302	44	2	~~3~~

20

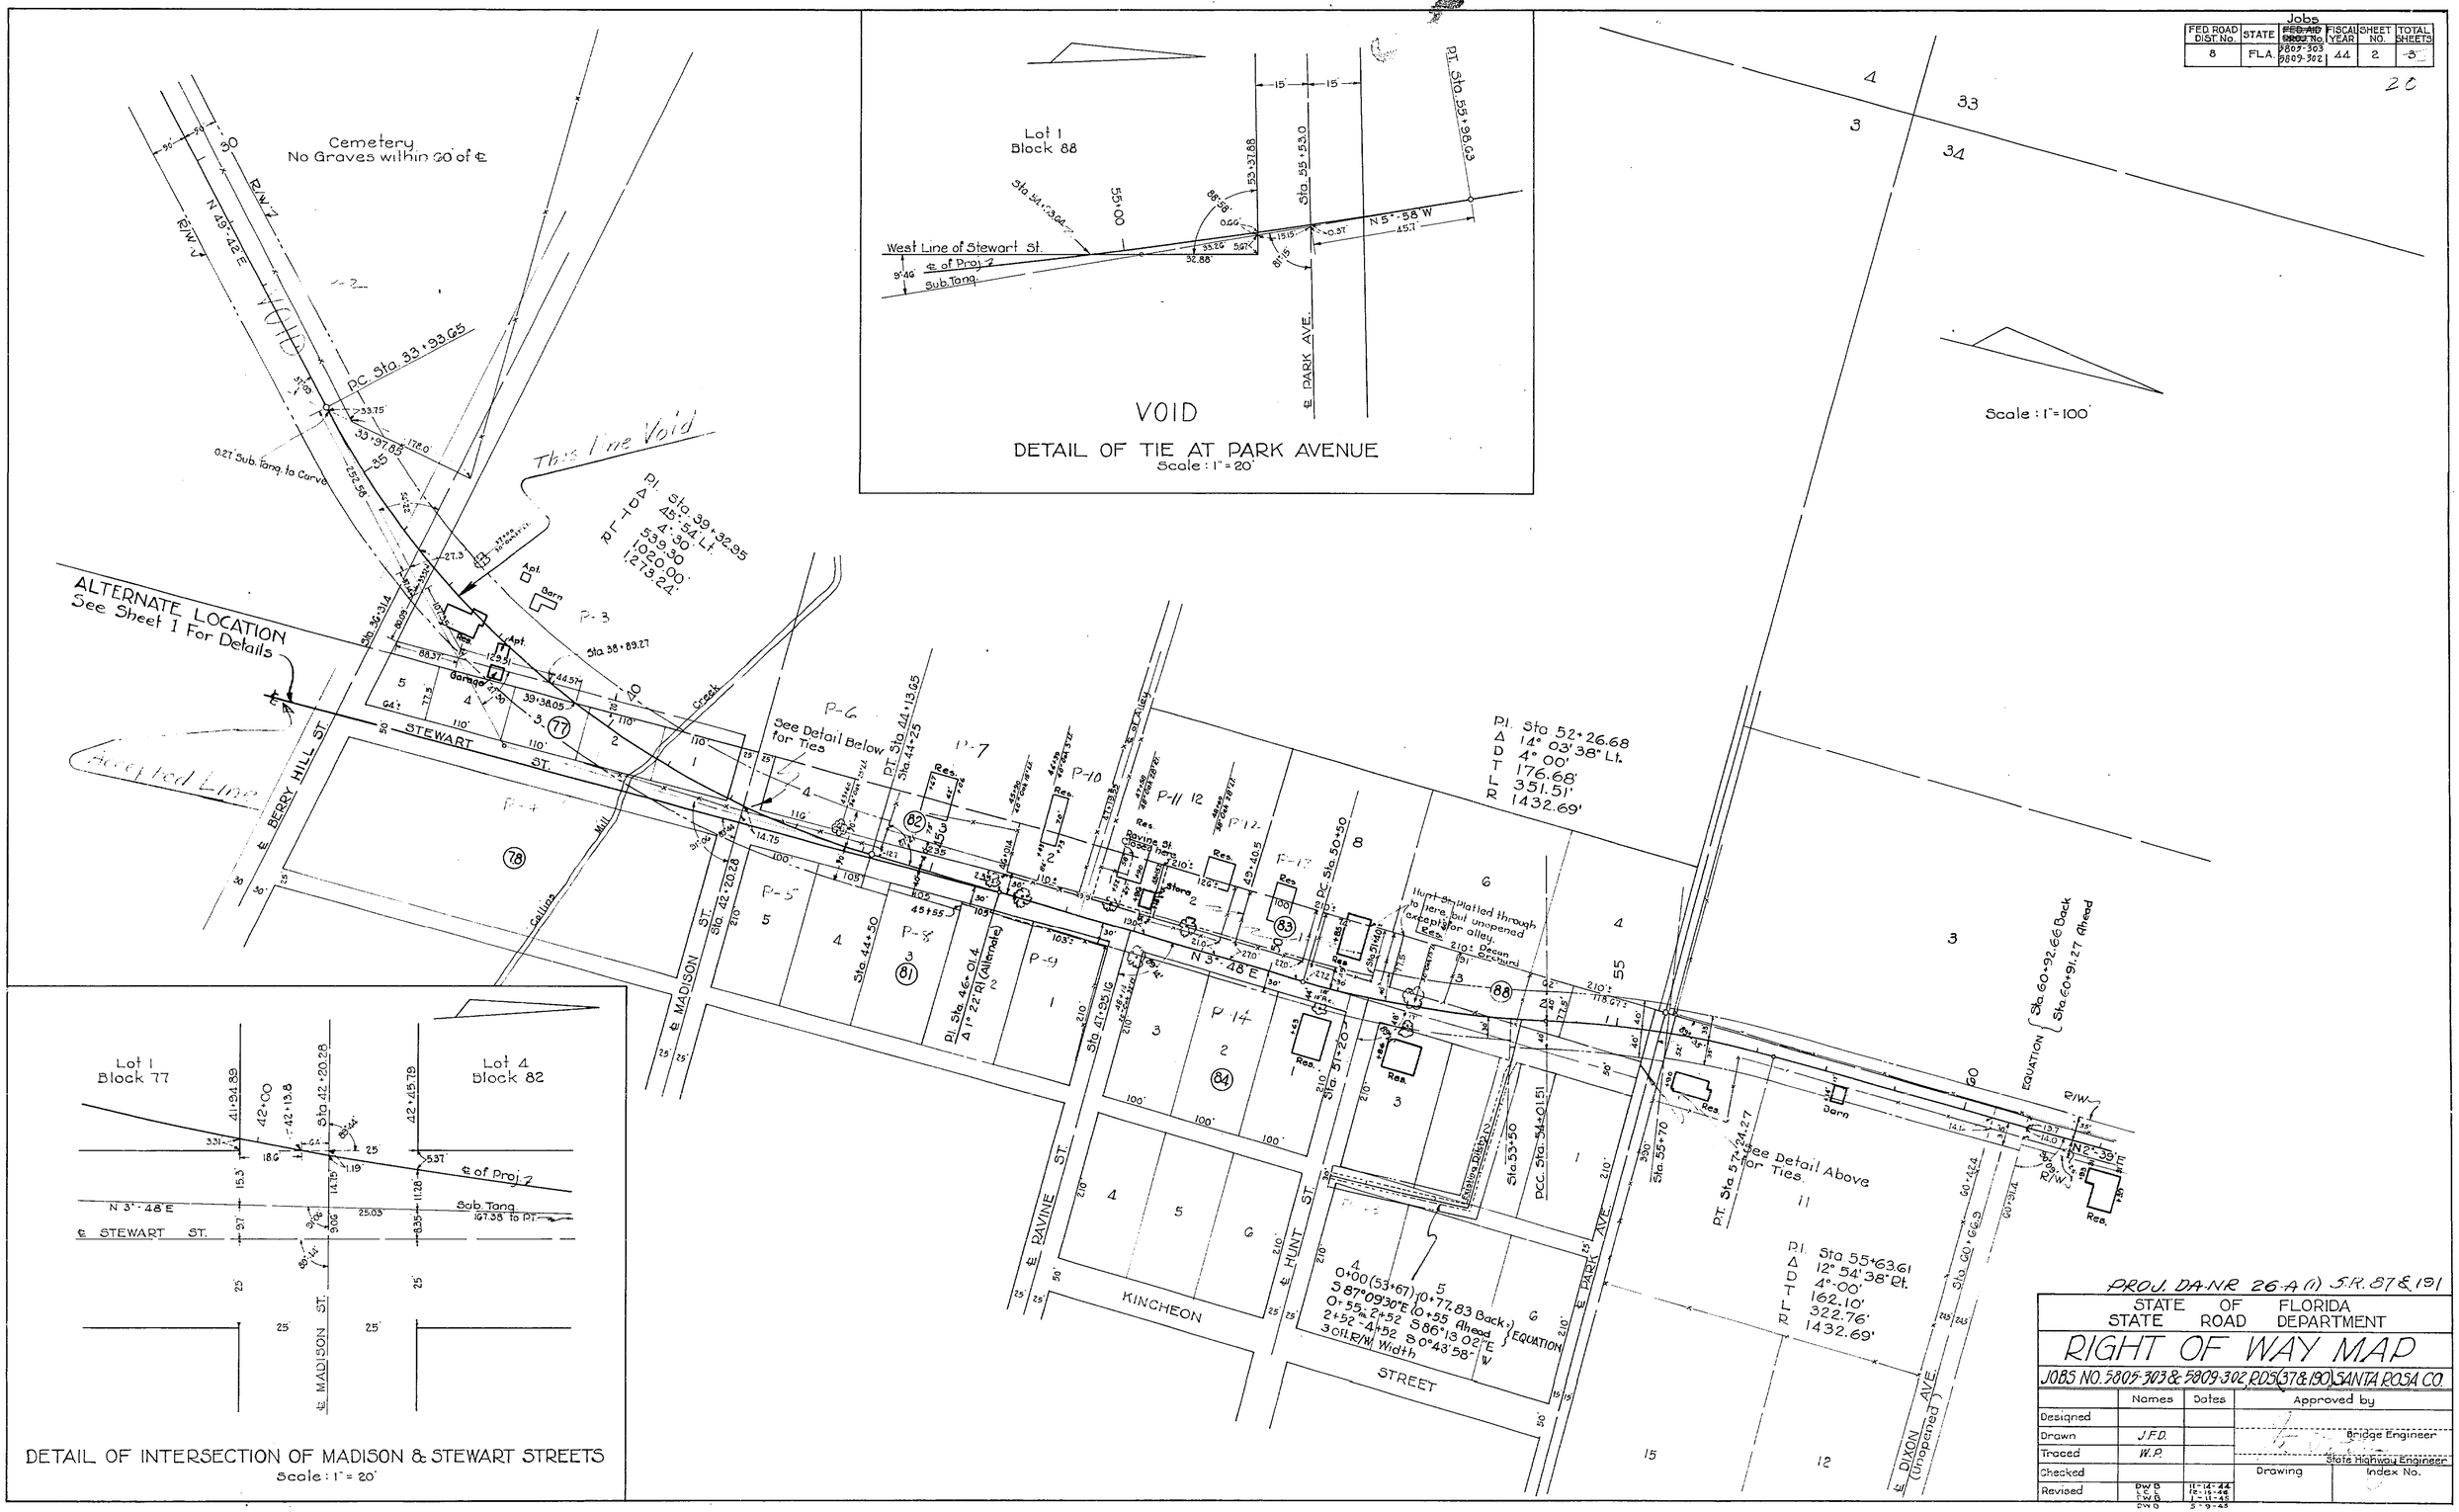

PROJ. DA-NR 26-A (1) S.R. 87 & 191

STATE OF FLORIDA
STATE ROAD DEPARTMENT

RIGHT OF WAY MAP

JOBS NO. 5805-303 & 5809-302, RDS (37 & 190), SANTA ROSA CO.

	Names	Dates	Approved by
Designed			
Drawn	J.F.D.		Bridge Engineer
Traced	W.P.		State Highway Engineer
Checked			Drawing / Index No.
Revised	DWB / LCL / DWB / DWB	11-14-44 / 12-15-44 / 1-11-45 / 5-9-45	

FED. ROAD DIST. No.	STATE	Jobs ~~FED. AID~~ ~~PROJ.~~ No.	FISCAL YEAR	SHEET NO.	TOTAL SHEETS
8	FLA.	5805-303 5809-302	44	3	3

21

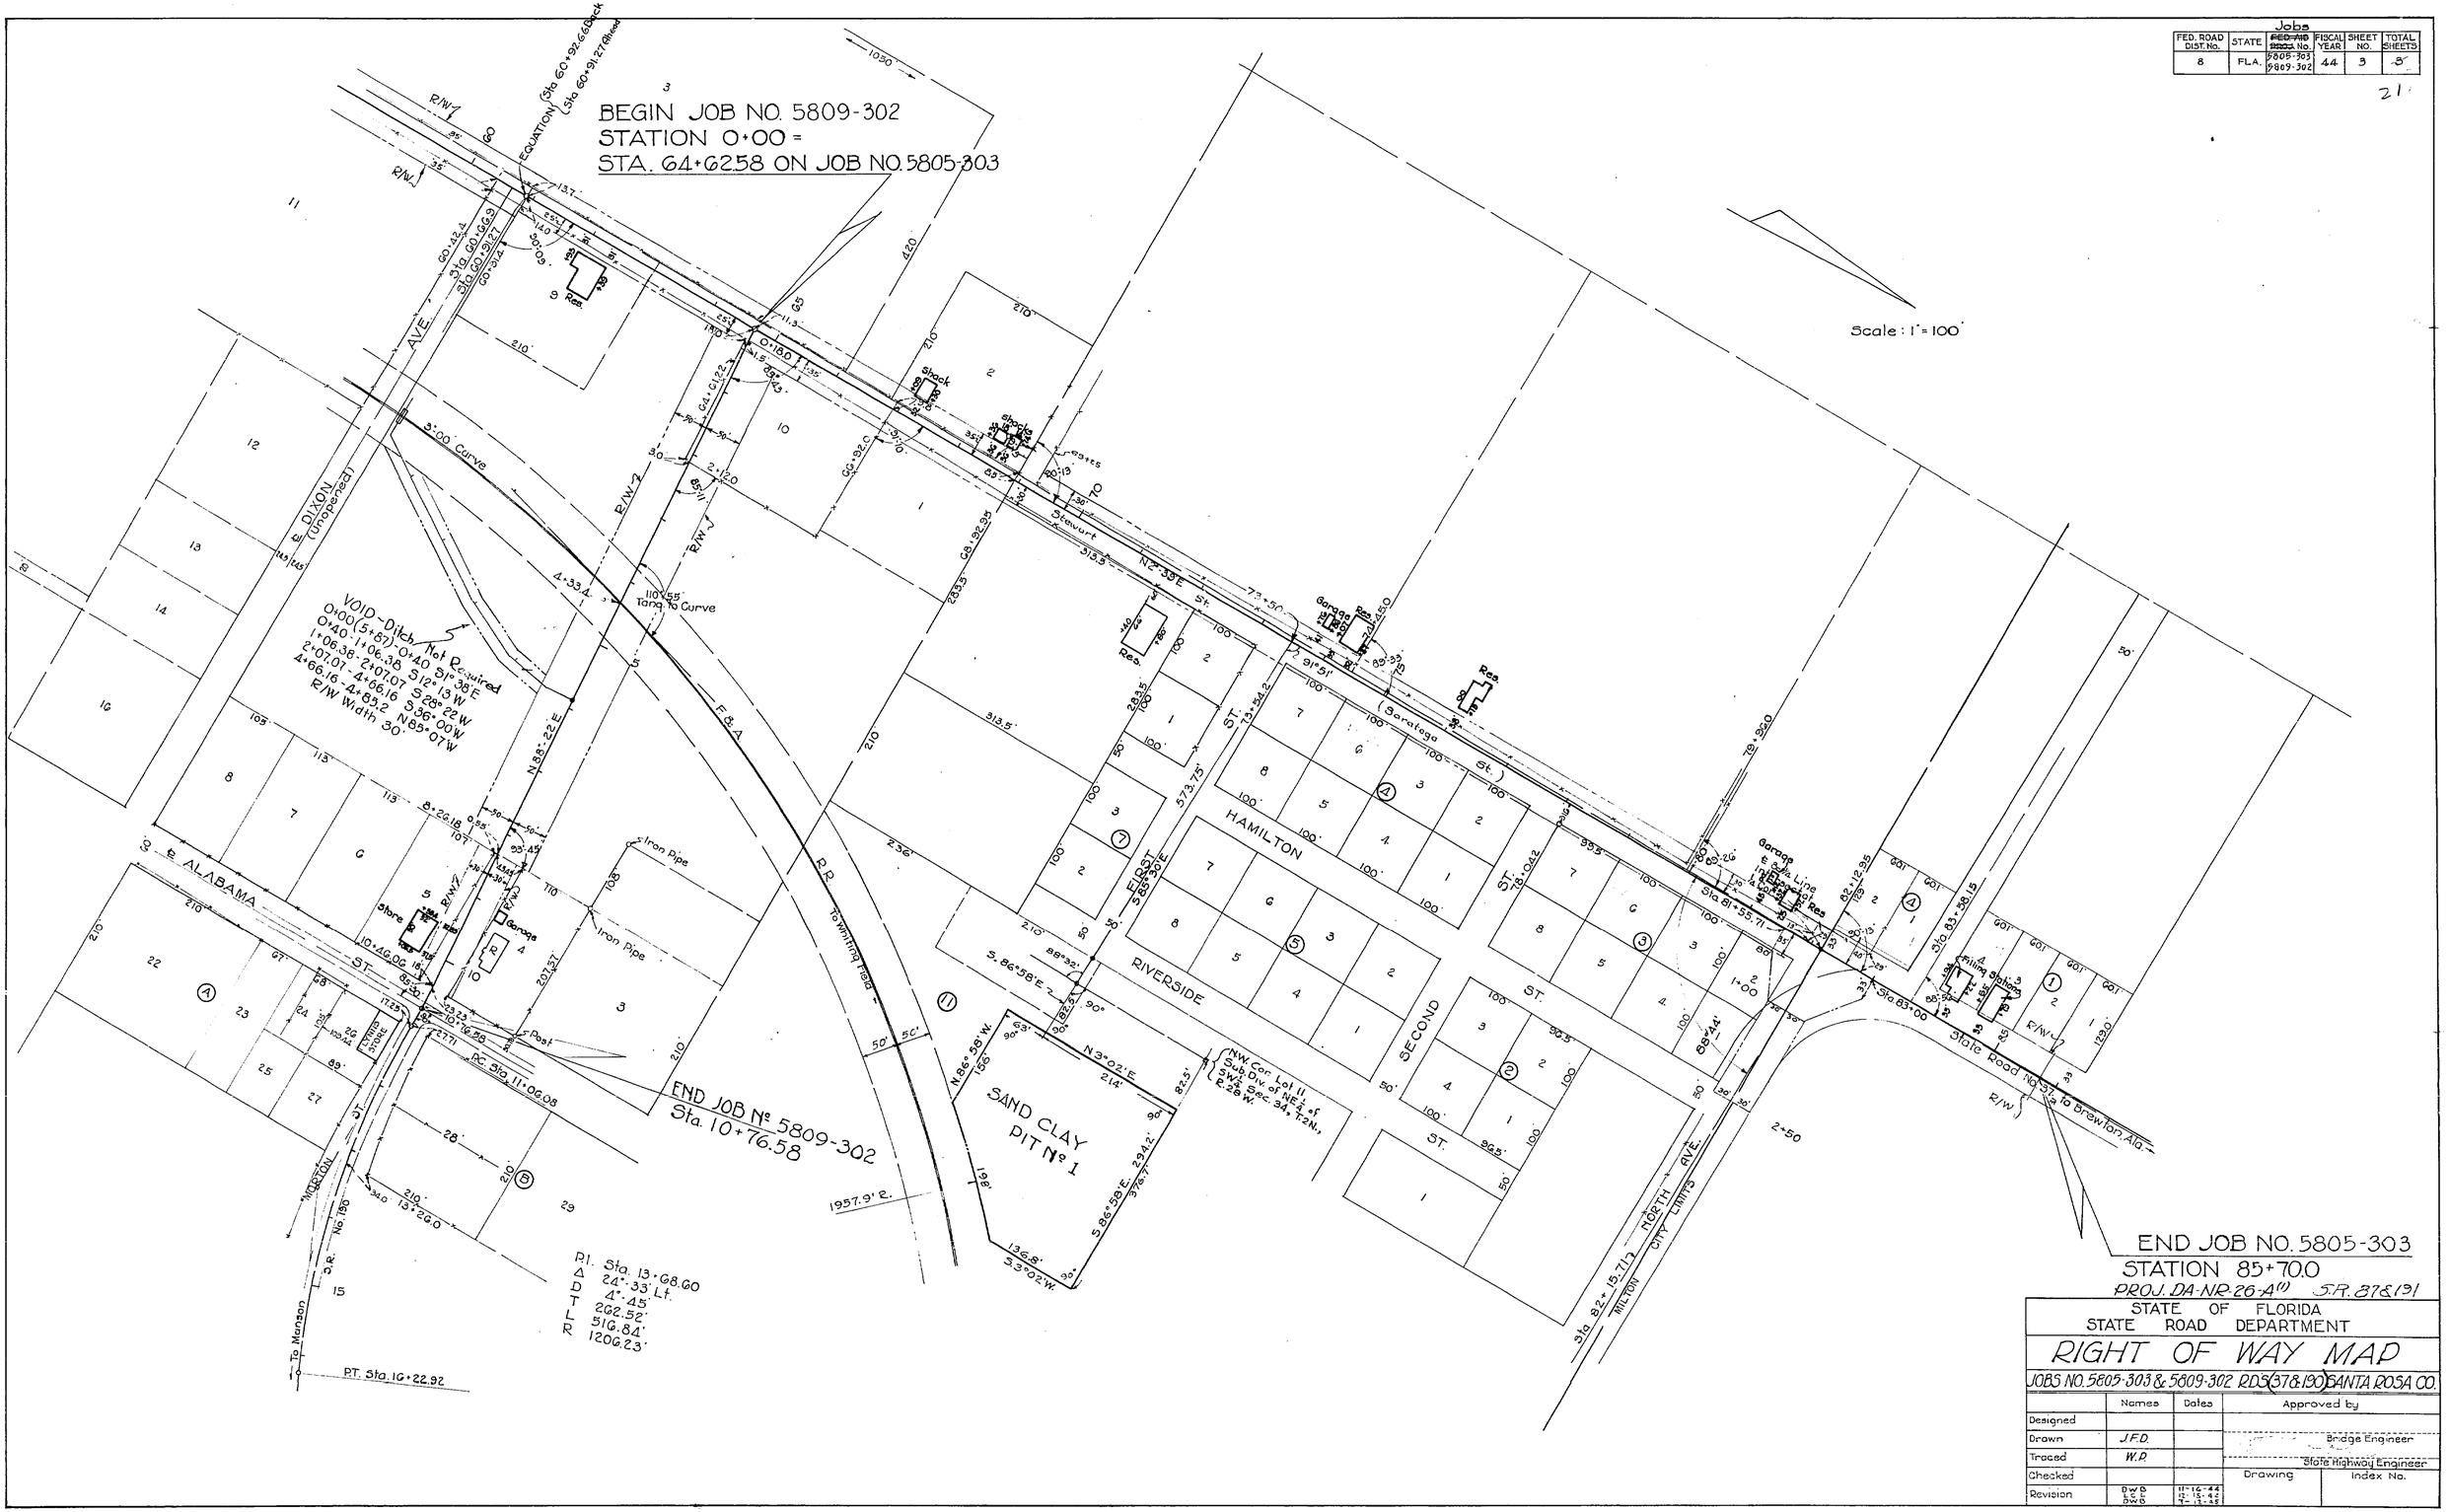

END JOB NO. 5805-303
STATION 85+70.0
PROJ. DA-NR-26-A(1) S.R. 87 & 191

STATE OF FLORIDA
STATE ROAD DEPARTMENT

RIGHT OF WAY MAP

JOBS NO. 5805-303 & 5809-302 RDS (37 & 190) SANTA ROSA CO.

	Names	Dates	Approved by
Designed			
Drawn	J.F.D.		Bridge Engineer
Traced	W.P.		State Highway Engineer
Checked			Drawing / Index No.
Revision	DWB LCL DWB	11-16-44 12-15-44 7-13-45	